


1 LOCATION OF WATER WELL: County: **Finney** Fraction: **SW 1/4 SW 1/4 NW 1/4** Section Number: **27** Township Number: **T 24 S** Range Number: **R 23** **EW**

Distance and direction from nearest town or city street address of well if located within city?
From Garden City - 1/2 Mile South, 3/4 Miles West, 1/2 Mile South - East into yard

2 WATER WELL OWNER: **Circle Feeders**
 RR#, St. Address, Box #: **P. O. Box 1255**
 City, State, ZIP Code: **Garden City, Kansas 67846**
 Board of Agriculture, Division of Water Resources
 Application Number:

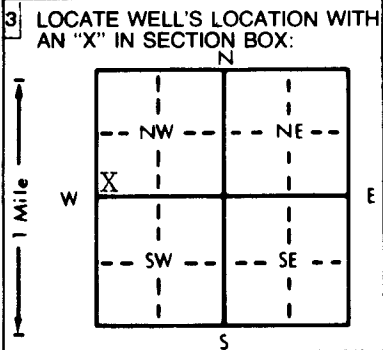

4 DEPTH OF COMPLETED WELL: **342** ft. ELEVATION:
 Depth(s) Groundwater Encountered 1. ft. 2. ft. 3. ft.
 WELL'S STATIC WATER LEVEL: **104** ft. below land surface measured on mo/day/yr **10-13-83**
 Pump test data: Well water was ft. after hours pumping gpm
 Est. Yield gpm: Well water was ft. after hours pumping gpm
 Bore Hole Diameter: **26** in. to **342** ft., and in. to ft.
 WELL WATER TO BE USED AS:
 5 Public water supply 8 Air conditioning 11 Injection well
 1 Domestic **3** Feedlot 6 Oil field water supply 9 Dewatering 12 Other (Specify below)
 2 Irrigation 4 Industrial 7 Lawn and garden only 10 Monitoring well
 Was a chemical/bacteriological sample submitted to Department? Yes.....No. **X**; If yes, mo/day/yr sample was submitted
 Water Well Disinfected? Yes **X** No

5 TYPE OF BLANK CASING USED:
 Steel 3 RMP (SR) 5 Wrought iron 8 Concrete tile CASING JOINTS: Glued Clamped
 PVC 4 ABS 6 Asbestos-Cement 9 Other (specify below) Welded **X**
 Fiberglass Threaded
 Blank casing diameter **16** in. to **170** ft., Dia in. to ft., Dia in. to ft.
 Casing height above land surface **12** in., weight **36.87** lbs./ft. Wall thickness or gauge No. **219**
 TYPE OF SCREEN OR PERFORATION MATERIAL:
 Steel 3 Stainless steel 5 Fiberglass 8 RMP (SR) 10 Asbestos-cement
 Brass 4 Galvanized steel 6 Concrete tile 9 ABS 11 Other (specify)
 12 None used (open hole)
 SCREEN OR PERFORATION OPENINGS ARE:
 1 Continuous slot Mill slot 5 Gauzed wrapped 8 Saw cut 11 None (open hole)
 Louvered shutter 4 Key punched Wire wrapped 9 Drilled holes
 Torch cut 10 Other (specify)
 SCREEN-PERFORATED INTERVALS: From **170** ft. to **342** ft., From ft. to ft.
 From ft. to ft., From ft. to ft.
 GRAVEL PACK INTERVALS: From **10** ft. to **342** ft., From ft. to ft.
 From ft. to ft., From ft. to ft.

6 GROUT MATERIAL: 1 Neat cement Cement grout 3 Bentonite 4 Other
 Grout Intervals: From **0** ft. to **10** ft., From ft. to ft., From ft. to ft.
 What is the nearest source of possible contamination:
 1 Septic tank 4 Lateral lines 7 Pit privy Livestock pens 14 Abandoned water well
 2 Sewer lines 5 Cess pool 8 Sewage lagoon 11 Fuel storage 15 Oil well/Gas well
 3 Watertight sewer lines 6 Seepage pit 9 Feedyard 12 Fertilizer storage 16 Other (specify below)
 13 Insecticide storage
 Direction from well? **South** How many feet? **200 Ft.**

FROM	TO	LITHOLOGIC LOG	FROM	TO	PLUGGING INTERVALS
		See attached log			

7 CONTRACTOR'S OR LANDOWNER'S CERTIFICATION: This water well was constructed, (2) reconstructed, or (3) plugged under my jurisdiction and was completed on (mo/day/year) **10-13-83** and this record is true to the best of my knowledge and belief. Kansas Water Well Contractor's License No. **208** This Water Well Record was completed on (mo/day/yr) **11-5-83** under the business name of **Minter-Wilson Drilling Co., Inc.** by (signature) *Nora Keller*

INSTRUCTIONS: Use typewriter or ball point pen. PLEASE PRESS FIRMLY and PRINT clearly. Please fill in blanks, underline or circle the correct answers. Send top three copies to Kansas Department of Health and Environment, Bureau of Water, Topeka, Kansas 66620-0001. Telephone: 913-296-5545. Send one to WATER WELL OWNER and retain one for your records.

OFFICE USE ONLY
T
R
EW
SEC.

The Professionals

MINTER-WILSON DRILLING CO.
INCORPORATED

Irrigation
and Domestic
Water Systems
Complete Installation
and Repairing

Phone 276-8269 • P.O. Box A • GARDEN CITY, KANSAS 67846

Circle Feeders
Finney Co.
5/18/1983

Location: NW 27-24-34
North side of feed yard
Static Water Level 87

Test #1

0	100 ⁹	Fine sand
10	33 ⁰⁹	Medium to coarse sand
33	94	Brown sandy clay
94	109 ⁴	Brown sandy clay fine to Med. sand & gravel mixture
109	129 ¹⁷	Fine to Medium sand & gravel coarse gravel (Loose)
129	140 ⁰⁴	Brown sandy clay
140	152 ¹⁷	Fine to Medium sand & gravel (Loose)
152	168 ⁰⁴	Brown sandy clay
168	185 ⁰¹	Fine to medium sand & gravel, streaks of clay (10% loose)
185	200 ¹⁷	Fine to medium sand & gravel (Loose)
200	222 ⁰¹	Fine to medium sand & gravel, streaks of clay (10% Loose) some coarse gravel
222	280 ¹⁷	Fine to medium sand & gravel (Loose)
280	296 ⁰⁴	Brown sandy clay
296	328 ¹⁷	Fine to medium sand & gravel (Loose)
328	350 ⁰¹	Brown clay
350	354 ¹⁷	Fine to medium sand & gravel (Loose)
354	356 ⁰¹	Yellow clay
356	380	Shale Used pull down
380	400	Shale hard. Used pull down
400	425 ¹⁹	Shale hard