


1] LOCATION OF WATER WELL:	Fraction	Section Number	Township Number	Range Number
County: <u>Hodgeman</u>	<u>NE 1/4 NE 1/4 SE 1/4</u>	<u>2</u>	T <u>24</u> S	R <u>23</u> E <u>W</u>

Distance and direction from nearest town or city street address of well if located within city?

From Idmore 6 miles south on 283 then 5 miles east

2] WATER WELL OWNER: <u>Dan Schaffer</u>	Board of Agriculture, Division of Water Resources
RR#, St. Address, Box #: <u>Rt. 1</u>	Application Number:
City, State, ZIP Code: <u>Spearville, KS 67876</u>	

3] LOCATE WELL'S LOCATION WITH AN "X" IN SECTION BOX:	4] DEPTH OF COMPLETED WELL: <u>216'</u> ft. ELEVATION:
---	--

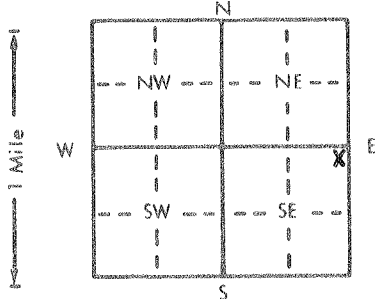

Depth(s) Groundwater Encountered 1. ft. 2. ft. 3. ft.
WELL'S STATIC WATER LEVEL ... <u>116'</u> ft. below land surface measured on mo/day/yr ... <u>2-12-94</u>
Pump test data: Well water was ft. after hours pumping gpm
Est. Yield gpm: Well water was ft. after hours pumping gpm
Bore Hole Diameter. <u>9 7/8"</u> in. to ft., and in. to ft.
WELL WATER TO BE USED AS:
1 Domestic 3 Feedlot 6 Oil field water supply 9 Dewatering 11 Injection well
2 Irrigation 4 Industrial 7 Lawn and garden only 10 Monitoring well 12 Other (Specify below)
Was a chemical/bacteriological sample submitted to Department? Yes. No. <u>X</u> If yes, mo/day/yr sample was submitted
Water Well Disinfected? Yes <u>X</u> No

5] TYPE OF BLANK CASING USED:	5 Wrought iron	8 Concrete tile	CASING JOINTS: Glued <u>X</u> Clamped
1 Steel	3 RMP (SR)	9 Other (specify below)	Welded
<u>2 PVC</u>	4 ABS		Threaded

Blank casing diameter ... <u>5"</u> in. to ft., Dia ... in. to ft., Dia ... in. to ft.
Casing height above land surface ... <u>12"</u> in., weight ... lbs./ft. Wall thickness or gauge No. <u>SDR 21</u>

TYPE OF SCREEN OR PERFORATION MATERIAL:	<u>7 PVC</u>	10 Asbestos-cement
1 Steel	8 RMP (SR)	11 Other (specify)
2 Brass	9 ABS	12 None used (open hole)
3 Stainless steel		
4 Galvanized steel		
5 Fiberglass		
6 Concrete tile		

SCREEN OR PERFORATION OPENINGS ARE:	5 Gauzed wrapped	<u>8 Saw cut</u>	11 None (open hole)
1 Continuous slot	6 Wire wrapped	9 Drilled holes	
2 Louvered shutter	7 Torch cut	10 Other (specify)	
4 Key punched			

SCREEN-PERFORATED INTERVALS:	From ... <u>174'</u> ft. to ... <u>216'</u> ft.	From ... ft. to ... ft.
GRAVEL PACK INTERVALS:	From ... <u>4'</u> ft. to ... <u>175'</u> ft.	From ... <u>180'</u> ft. to ... <u>216'</u> ft.

6] GROUT MATERIAL:	1 Neat cement	2 Cement grout	<u>3 Bentonite</u>	4 Other
Grout Intervals:	From ... <u>4'</u> ft. to ... <u>24'</u> ft.	From ... <u>175'</u> ft. to ... <u>180'</u> ft.	From ... ft. to ... ft.	

What is the nearest source of possible contamination:	<u>10 Livestock pens</u>	14 Abandoned water well
1 Septic tank	11 Fuel storage	15 Oil well/Gas well
2 Sewer lines	12 Fertilizer storage	16 Other (specify below)
3 Watertight sewer lines	13 Insecticide storage	
4 Lateral lines		
5 Cess pool		
6 Seepage pit		
7 Pit privy		
8 Sewage lagoon		
9 Feedyard		

Direction from well? <u>South</u>	How many feet? <u>15'</u>
-----------------------------------	---------------------------

FROM	TO	LITHOLOGIC LOG	FROM	TO	PLUGGING INTERVALS
0	2	Topsoil			
2	30	Brown clay			
30	45	Brown clay + limestone			
45	97	Shale			
97	105	Sandstone			
105	148	Shale			
148	155	Sandstone			
155	180	Shale			
180	216	Sandstone			

7] CONTRACTOR'S OR LANDOWNER'S CERTIFICATION: This water well was <u>(1) constructed</u> , (2) reconstructed, or (3) plugged under my jurisdiction and was completed on (mo/day/year) ... <u>2-12-94</u> ... and this record is true to the best of my knowledge and belief. Kansas Water Well Contractor's License No. ... <u>533</u> ... This Water Well Record was completed on (mo/day/yr) ... <u>3-28-94</u> ... under the business name of <u>Jantzen Water Well Repair</u> by (signature) <u>[Signature]</u>
