


1 LOCATION OF WATER WELL: Fraction SE 1/4 SE 1/4 SE 1/4 Section Number 3 Township Number T 24 S Range Number R 23 EW

Distance and direction from nearest town or city street address of well if located within city?
6 miles south-4miles east of Jetmore

2 WATER WELL OWNER: Earl Schaffer
RR#, St. Address, Box # : Rt. 2 Board of Agriculture, Division of Water Resources
City, State, ZIP Code : Jetmore, Ks. 67854 Application Number:

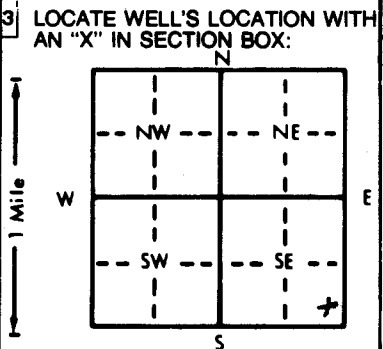

4 DEPTH OF COMPLETED WELL... 56 ft. ELEVATION:
Depth(s) Groundwater Encountered 1. 33 1/2 ft. 2. ft. 3. ft.
WELL'S STATIC WATER LEVEL ... 33 1/2 ft. below land surface measured on mo/day/yr 3-20-89
Pump test data: Well water was 38 ft. after 2 hours pumping 10 gpm
Est. Yield .20 gpm: Well water was ft. after hours pumping gpm
Bore Hole Diameter .8 in. to .56 ft., and .in. to .ft.
WELL WATER TO BE USED AS: 5 Public water supply 8 Air conditioning 11 Injection well
1 Domestic 3 Feedlot 6 Oil field water supply 9 Dewatering 12 Other (Specify below)
2 Irrigation 4 Industrial 7 Lawn and garden only 10 Observation well
Was a chemical/bacteriological sample submitted to Department? Yes.....No. X.....; If yes, mo/day/yr sample was submitted
Water Well Disinfected? Yes X No

5 TYPE OF BLANK CASING USED:
1 Steel 3 RMP (SR) 5 Wrought iron 8 Concrete tile CASING JOINTS: Glued X Clamped
2 PVC 4 ABS 6 Asbestos-Cement 9 Other (specify below) Welded
7 Fiberglass Threaded
Blank casing diameter .5 in. to .39 1/2 ft., Dia .in. to .ft., Dia .in. to .ft.
Casing height above land surface .18 in., weight lbs./ft. Wall thickness or gauge No. .250
TYPE OF SCREEN OR PERFORATION MATERIAL:
1 Steel 3 Stainless steel 5 Fiberglass 7 PVC 10 Asbestos-cement
2 Brass 4 Galvanized steel 6 Concrete tile 8 RMP (SR) 11 Other (specify)
12 None used (open hole)
SCREEN OR PERFORATION OPENINGS ARE:
1 Continuous slot 3 Mill slot 5 Gauzed wrapped 8 Saw cut 11 None (open hole)
2 Louvered shutter 4 Key punched 6 Wire wrapped 9 Drilled holes
7 Torch cut 10 Other (specify)
SCREEN-PERFORATED INTERVALS: From .39 1/2 ft. to .56 ft., From ft. to .ft.
GRAVEL PACK INTERVALS: From .20 ft. to .56 ft., From ft. to .ft.
From ft. to ft., From ft. to ft.

6 GROUT MATERIAL: 1 Neat cement 2 Cement grout 3 Bentonite 4 Other
Grout Intervals: From .0 ft. to .20 ft., From ft. to .ft., From ft. to .ft.
What is the nearest source of possible contamination:
1 Septic tank 4 Lateral lines 7 Pit privy 10 Livestock pens 14 Abandoned water well
2 Sewer lines 5 Cess pool 8 Sewage lagoon 11 Fuel storage 15 Oil well/Gas well
3 Watertight sewer lines 6 Seepage pit 9 Feedyard 12 Fertilizer storage 16 Other (specify below)
13 Insecticide storage N.O.I.E.
Direction from well? How many feet?

FROM	TO	LITHOLOGIC LOG	FROM	TO	LITHOLOGIC LOG
0	17	topsoil & clay			
17	26	sand			
26	38	clay			
38	45	sand & clay streaks			
45	55	sand & clay streaks			
55	56	clay			

FACTORY'S OR LANDOWNER'S CERTIFICATION: This water well was (1) constructed, (2) reconstructed, or (3) plugged under my jurisdiction and was on (mo/day/year) 3-29-89 and this record is true to the best of my knowledge and belief. Kansas Contractor's License No. 130 This Water Well Record was completed on (mo/day/yr) 4-8-89
business name of Leo Knoefler ~~XXXX~~ Drilling by (signature) Leo Knoefler
IONS: Use typewriter or ball point pen. PLEASE PRESS FIRMLY and PRINT clearly. Please fill in blanks, underline or circle the correct answers. Send to three copies to Kansas of Health and Environment, Bureau of Water Protection, Topeka, Kansas 66620-7320, Telephone: 913-862-9360. Send one to WATER WELL OWNER and retain one for your

OFFICE USE ONLY T R EWM SEC. 1/4 1/4 1/4