SPEARVILLE NE

USE TYPEWRITER OR BALL POINT PEN-PRESS FIRMLY, PRINT CLEARLY.

WATER WELL RECORD
KSA 82a-1201-1215

CORRECTED COPY AAA

Kansas Department of Health and Environment-Division of Environment
(Water well Contractors)
Topeka, Kansas 66620

1. Location of well:	County	Fraction	Section number	Township number	Range number
	Hodgeman	NE 1/4 NE 1/4 NE 1/4	#28	T #24 S	R #23 X/W

2. Distance and direction from nearest town or city: 9 miles south, 3 east of Jetmore, Kansas
Street address of well location if in city:

3. Owner of well: Raymond Fagen
R.R. or street:
City, state, zip code: Spearville, Kansas

4. Locate with "X" in section below: Sketch map:

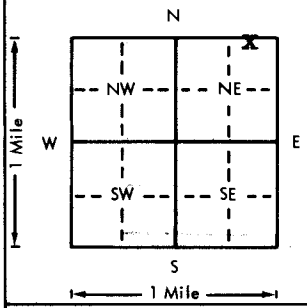

NE¼ of the NE¼ of the NE¼ of Section #28 T #24 R #23 W

6. Bore hole dia. 70 in. Completion date 6-23-75
Well depth 8 ft.

7. __ Cable tool X Rotary __ Driven __ Dug
__ Hollow rod __ Jetted __ Bored __ Reverse rotary

8. Use: X Domestic __ Public supply __ Industry
__ Irrigation __ Air conditioning __ Stock
__ Lown __ Oil field water __ Other

9. Casing: Material RMP Height: Above ~~or below~~
Threaded ___ Welded ___ Surface 12 in.
RMP X PVC ___ Weight ___ lbs./ft.
Dia. 5 in. to 70 ft. depth Wall Thickness: inches or
Dia. ___ in. to ___ ft. depth gage No. 250

5. Type and color of material	From	To
Top soil & fine to medium sand	0	15
Fine sand & rock layers	15	30
Rock layers & mdium sand	30	45
Medium to coarse sand	45	61
Clay & blue shale	61	70
BROCK 61'		
47		
14 Set block		
in Alluvium		
(Use a second sheet if needed)		

10. Screen: Manufacturer's name Sunflower
Type RMP Dia. 5"
Slot/gauze 1/8" Length 20 ft.
Set between 50 ft. and 70 ft.
___ ft. and ___ ft.
Gravel pack? yes Size range of material ¼"

11. Static water level: mo./day/yr.
47 ft. below land surface Date 6-23-75

12. Pumping level below land surfaces:
65 ft. after 2 hrs. pumping 48 g.p.m.
___ ft. after ___ hrs. pumping ___ g.p.m.
Estimated maximum yield 48 g.p.m.

13. Water sample submitted: mo./day/yr.
__ Yes X No Date

14. Well head completion: None
__ Pitless adapter ___ Inches above grade

15. Well grouted? yes
With: __ Neat cement X Bentonite __ Concrete
Depth: From 4 ft. to 15 ft.

16. Nearest source of possible contamination: None
ft. ___ Direction ___ Type ___
Well disinfected upon completion? X Yes __ No

17. Pump: __ Not installed
Manufacturer's name Flint & Walling
Model number 15DF5 HP 1½ Volts 230
Length of drop pipe 63 ft. capacity 35 g.p.m.
Type:
X Submersible __ Turbine
__ Jet __ Reciprocating
__ Centrifugal __ Other

18. Elevation:
Topography:
X Hill
__ Slope
__ Upland
__ Valley

19. Remarks:
2 314
61
1016

20. Water well contractor's certification:
This well was drilled under my jurisdiction and this report is true to the best of my knowledge and belief.
JOE'S WELL SERVICE 179
Business name License No.
Address Box 174 Cimarron, Ks.
Signed Larry L Crick Date 9-4-75
Authorized representative

T 24 R 23 E W Sec 28 1/4 NE 1/4 NE 1/4 NE 1/4

Forward the white, blue and pink copies to the Department of Health and Environment

Form WWC-5

MI-1023