


WATER WELL RECORD Form WWC-5 KSA 82a-1212

1 LOCATION OF WATER WELL: Fraction Section Number Township Number Range Number
 COUNTY: HODGENAM SE 1/4 SE 1/4 SW 1/4 18 T 24 S R 23 W

Distance and direction from nearest town or city street address of well if located within city?
 FROM JETMORE - SOUTH ON HIGHWAY 283 TO RD. D - 1/4 EAST

2 WATER WELL OWNER: BRADFORD, DENNIS Board of Agriculture, Division of Water Resources
 RR#, St. Address, Box #: 28522 SE D RD. Application Number:
 City, State, ZIP code: JETMORE, KS 67854-

3 LOCATE WELL'S LOCATION WITH AN "X" IN SECTION BOX:

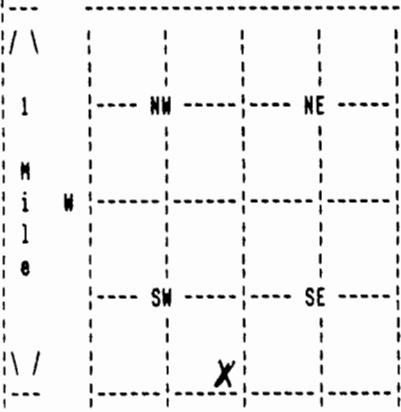

4 DEPTH OF COMPLETED WELL 85 ELEVATION: 0
 Depth(s) Groundwater Encountered 1. 0 ft. 2. 0 ft. 3. 0 ft.

WELL'S STATIC WATER LEVEL 43 ft. below land surface measured on mo/day/yr 09/15/09
 Pump test data: Well water was 0 ft. after 0 hours pumping 0 gpm

Estimated Yield 25 gpm: Well water was 0 ft. after 0 hours pumping 0 gpm

Bore Hole Diameter 10 in. to 85 ft., and in. to 0 ft.

WELL WATER TO BE USED AS: DOMESTIC

Was a chemical/bacteriological sample submitted to department? No ;
 If yes, mo/day/yr sample was submitted Water well disinfected? Yes

5 TYPE OF BLANK CASING USED: CERTA LOC CASIM CASING JOINTS: CERTA-LOC
 Blank casing diameter 5 in. to 85 ft., Dia in. to 0 ft., Dia in. to 0 ft.
 Casing height above land surface 12 in., weight 200 lbs/ft. Wall thickness or gauge No. 21
 TYPE OF SCREEN OR PERFORATION MATERIAL: PVC
 SCREEN OR PERFORATION OPENINGS ARE: SAW CUT

SCREEN PERFORATED INTERVALS: From 60 ft. to 80 ft., From 0 ft. to 0 ft.
 From 0 ft. to 0 ft., From 0 ft. to 0 ft.
 GRAVEL PACK INTERVALS: From 27 ft. to 85 ft., From 0 ft. to 0 ft.
 From 0 ft. to 0 ft., From 0 ft. to 0 ft.

6 GROUT MATERIAL BENTONITE
 Grout Intervals: From 6 ft. to 27 ft., From 0 ft. to 0 ft., From 0 ft. to 0 ft.
 What is the nearest source of possible contamination: NONE
 Direction from well? How many feet? 0

FROM	TO	LITHOLOGIC LOG	FROM	TO	PLUGGING INTERVALS
0	20	01 TOPSOIL 14 WHITE CLAY 02 FINE SAND			
20	50	02 FINE SAND 35 CALACHIE 32 TAN CLAY			
50	75	37 FIN-COAR SAN 06 SMALL GRAVEL			
75	100	16 GRAY CLAY 07 BLUE SHALE			

7 CONTRACTOR'S OR LANDOWNER'S CERTIFICATION: This water well was Constructed under my jurisdiction and was completed on (mo/day/year) 09/16/09 and this record is true to the best of my knowledge and belief. Kansas Water Well Contractor's License No. 179 This Water Well Record was completed on (mo/day/yr) 10/06/09 under the business name of JOE'S WELL SERVICE, INC. by (signature) *Judith Crick*