


WATER WELL RECORD Form WWC-5 KSA 82a-1212

1 LOCATION OF WATER WELL: Fraction Section Number Township Number Range Number
 COUNTY: Ford Hodgeman SW 1/4 SW 1/4 NE 1/4 20 T 24 S R 23 W (DRL)

Distance and direction from nearest town or city street address of well if located within city?
 WRIGHT - N ON 283 - EAST ON C RD. 2 MILES - 1/2 NORTH

2 WATER WELL OWNER: HOLMAN, WARNER MARCELLA Board of Agriculture, Division of Water Resources
 RR#, St. Address, Box #: 10580 SE 220 RD. Application Number:
 City, State, ZIP code: SPEARVILLE, KS 67895-

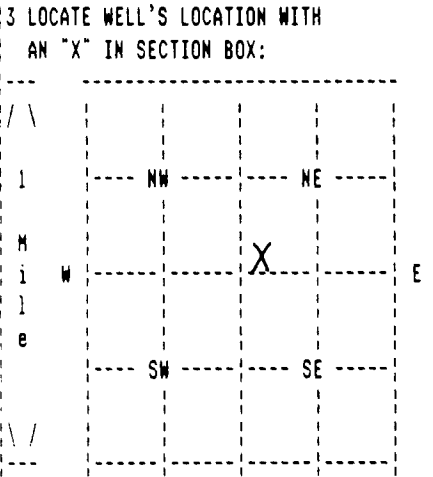

4 DEPTH OF COMPLETED WELL 54 ELEVATION: 0
 Depth(s) Groundwater Encountered 1. 0 ft. 2. 0 ft. 3. 0 ft.
 WELL'S STATIC WATER LEVEL 28 ft. below land surface measured on mo/day/yr 07/19/10
 Pump test data: Well water was 0 ft. after 0 hours pumping 0 gpm
 Estimated Yield 10 gpm: Well water was 0 ft. after 0 hours pumping 0 gpm
 Bore Hole Diameter 10 in. to 54 ft., and in. to 0 ft.
 WELL WATER TO BE USED AS: DOMESTIC
 Was a chemical/bacteriological sample submitted to department? No ;
 If yes, mo/day/yr sample was submitted Water well disinfected? Yes

5 TYPE OF BLANK CASING USED: CERTA LOC CASIN CASING JOINTS: CERTA-LOC
 Blank casing diameter 5 in. to 54 ft., Dia in. to 0 ft., Dia in. to 0 ft.
 Casing height above land surface 12 in., weight 200 lbs/ft. Wall thickness or gauge No. 21
 TYPE OF SCREEN OR PERFORATION MATERIAL: PVC
 SCREEN OR PERFORATION OPENINGS ARE: SAW CUT

SCREEN PERFORATED INTERVALS: From 28 ft. to 48 ft., From 0 ft. to 0 ft.
 From 0 ft. to 0 ft., From 0 ft. to 0 ft.
 GRAVEL PACK INTERVALS: From 25 ft. to 54 ft., From 0 ft. to 0 ft.
 From 0 ft. to 0 ft., From 0 ft. to 0 ft.

6 GROUT MATERIAL BENTONITE
 Grout Intervals: From 0 ft. to 25 ft., From 0 ft. to 0 ft., From 0 ft. to 0 ft.
 What is the nearest source of possible contamination: NONE
 Direction from well? How many feet? 0

FROM	TO	LITHOLOGIC LOG	FROM	TO	PLUGGING INTERVALS
0	5	01 TOPSOIL			
5	20	05 CLAY			
20	40	37 FIN-COAR SAN 06 SMALL GRAVEL			
40	60	36 BLUE CLAY 31 SHALE			

7 CONTRACTOR'S OR LANDOWNER'S CERTIFICATION: This water well was constructed under my jurisdiction and was completed on (mo/day/year) 07/19/10 and this record is true to the best of my knowledge and belief. Kansas Water Well Contractor's License No. 179 This Water Well Record was completed on (mo/day/yr) 08/10/10 under the business name of JOE'S WELL SERVICE, INC. by (signature) *Judith Cook*