


1 LOCATION OF WATER WELL: County: Hodgeman Fraction: NE 1/4 NE 1/4 SE 1/4 Section Number: 5 Township Number: T 24 S Range Number: R 24 E/W

Distance and direction from nearest town or city street address of well if located within city?
6 miles south-4 1/2 miles west of the town of Jetmore

2 WATER WELL OWNER: Ron Bach
 RR#, St. Address, Box #: _____
 City, State, ZIP Code: Jetmore, Kansas 67854
 Board of Agriculture, Division of Water Resources
 Application Number: _____

3 LOCATE WELL'S LOCATION WITH AN "X" IN SECTION BOX:

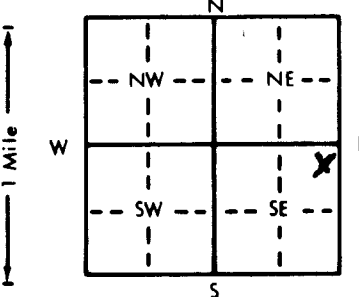

4 DEPTH OF COMPLETED WELL... 82 ft. ELEVATION: _____
 Depth(s) Groundwater Encountered 1. 40 ft. 2. _____ ft. 3. _____ ft.
 WELL'S STATIC WATER LEVEL 40 ft. below land surface measured on mo/day/yr 10-28-85
 Pump test data: Well water was _____ ft. after _____ hours pumping _____ gpm
 Est. Yield 30 gpm: Well water was _____ ft. after _____ hours pumping _____ gpm
 Bore Hole Diameter... 8 in. to 8 1/2 in. and _____ in. to _____ in.
 WELL WATER TO BE USED AS: 5 Public water supply 8 Air conditioning 11 Injection well
 1 Domestic 3 Feedlot 6 Oil field water supply 9 Dewatering 12 Other (Specify below)
 2 Irrigation 4 Industrial 7 Lawn and garden only 10 Observation well
 Was a chemical/bacteriological sample submitted to Department? Yes _____ No X If yes, mo/day/yr sample was submitted
 Water Well Disinfected? Yes X No

5 TYPE OF BLANK CASING USED: 5 Wrought iron 8 Concrete tile CASING JOINTS: Glued X Clamped _____
 1 Steel 3 RMP (SR) 6 Asbestos-Cement 9 Other (specify below) Welded _____
 2 PVC 4 ABS 7 Fiberglass _____ Threaded _____
 Blank casing diameter 5 in. to 8 1/2 ft., Dia. _____ in. to _____ ft., Dia. _____ in. to _____ ft.
 Casing height above land surface 18 in., weight _____ lbs./ft. Wall thickness or gauge No. 250

TYPE OF SCREEN OR PERFORATION MATERIAL: 7 PVC 10 Asbestos-cement
 1 Steel 3 Stainless steel 5 Fiberglass 8 RMP (SR) 11 Other (specify) _____
 2 Brass 4 Galvanized steel 6 Concrete tile 9 ABS 12 None used (open hole)

SCREEN OR PERFORATION OPENINGS ARE: 5 Gauzed wrapped 8 Saw cut 11 None (open hole)
 1 Continuous slot 3 Mill slot 6 Wire wrapped 9 Drilled holes
 2 Louvered shutter 4 Key punched 7 Torch cut 10 Other (specify) _____

SCREEN-PERFORATED INTERVALS: From 62 ft. to 82 ft., From _____ ft. to _____ ft.
 From 0 ft. to _____ ft., From _____ ft. to _____ ft.
 GRAVEL PACK INTERVALS: From 20 ft. to 82 ft., From _____ ft. to _____ ft.
 From _____ ft. to _____ ft., From _____ ft. to _____ ft.

6 GROUT MATERIAL: 1 Neat cement 2 Cement grout 3 Bentonite 4 Other _____
 Grout Intervals: From 3 ft. to 15 ft., From 15 ft. to 20 ft., From _____ ft. to _____ ft.

What is the nearest source of possible contamination: 10 Livestock pens 14 Abandoned water well
 1 Septic tank 4 Lateral lines 7 Pit privy 11 Fuel storage 15 Oil well/Gas well
 2 Sewer lines 5 Cess pool 8 Sewage lagoon 12 Fertilizer storage 16 Other (specify below)
 3 Watertight sewer lines 6 Seepage pit 9 Feedyard 13 Insecticide storage
 Direction from well? WEST How many feet? 300

FROM	TO	LITHOLOGIC LOG	FROM	TO	LITHOLOGIC LOG
0	3	topsoil			
3	34	caliche & clay			
34	40	caliche & sand streaks			
40	64	clay			
64	68	sand (coarse)			
68	71	clay			
71	77	sand (coarse)			
77	82	clay (yellow)			

7 CONTRACTOR'S OR LANDOWNER'S CERTIFICATION: This water well was (1) constructed, (2) reconstructed, or (3) plugged under my jurisdiction and was completed on (mo/day/year) 1-28-86 and this record is true to the best of my knowledge and belief. Kansas Water Well Contractor's License No. 130 This Water Well Record was completed on (mo/day/yr) 1-22-86 under the business name of LEO KNOFLER DRILLING by (signature) Leo Knopfler

INSTRUCTIONS: Use typewriter or ball point pen, PLEASE PRESS FIRMLY and PRINT clearly. Please fill in blanks, underline or circle the correct answers. Send top three copies to Kansas Department of Health and Environment, Division of Environment, Environmental Geology Section, Topeka, KS 66620. Send one to WATER WELL OWNER and retain one for your records.

OFFICE USE ONLY
T
R
E/W
SEC.
1/4
1/4
1/4