

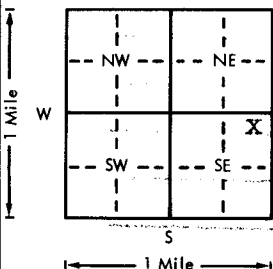
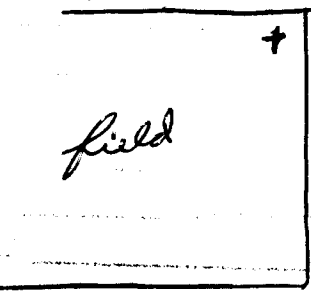
USE TYPEWRITER OR BALL  
POINT PEN-PRESS FIRMLY,  
PRINT CLEARLY.

SPR ARVILLE  
NW

WATER WELL RECORD  
KSA 82a-1201-1215

Kansas Department of Health and  
Environment-Division of Environment  
(Water well Contractors)  
Topeka, Kansas 66620

DAA

1. Location of well:	County <b>Hodgeman</b>	Fraction <b>NE 1/4 NE 1/4 SE 1/4</b>	Section number <b>10</b>	Township number <b>T 24 S</b>	Range number <b>R 24</b>
2. Distance and direction from nearest town or city: <b>6S, 2W, 1/2S</b> Street address of well location if in city: <b>of Jetmore</b>			3. Owner of well: <b>Jake Martens</b> R.R. or street: City, state, zip code: <b>Jetmore, Kansas 67854</b>		
4. Locate with "X" in section below: 			Sketch map: 		
5. Type and color of material			From	To	
Topsoil			0	3	
Clay white			3	55	
Clay brown			55	64	
Sand good			64	88	
Clay yellow			(88)	90	
BRock 88'					
66					
22' sat. thick					
in Og					
(Use a second sheet if needed)					
18. Elevation:  Topography: Hill Slope <input checked="" type="checkbox"/> Upland Valley	19. Remarks:  Concrete slab was installed  2486 88 2395 TOPO		20. Water well contractor's certification: This well was drilled under my jurisdiction and this report is true to the best of my knowledge and belief. <b>Knoefler Bros Drilling</b> Business name: <b>Jetmore</b> License No.: <b>150</b> Address: <b>Jetmore</b> Signed: <b>Dale Knoefler</b> Date: <b>12-27-78</b> Authorized representative		
6. Bore hole dia. <b>8</b> in. Completion date <b>12-4-78</b> Well depth <b>90</b> ft.			7. <input checked="" type="checkbox"/> Cable tool <input checked="" type="checkbox"/> Rotary <input type="checkbox"/> Driven <input type="checkbox"/> Dug <input type="checkbox"/> Hollow rod <input type="checkbox"/> Jetted <input type="checkbox"/> Bored <input type="checkbox"/> Reverse rotary		
8. Use: <input type="checkbox"/> Domestic <input type="checkbox"/> Public supply <input checked="" type="checkbox"/> Industry <input type="checkbox"/> Irrigation <input type="checkbox"/> Air conditioning <input checked="" type="checkbox"/> Stock <input type="checkbox"/> Lawn <input type="checkbox"/> Oil field water <input type="checkbox"/> Other			9. Casing: Material <b>plst</b> Height <b>Above</b> or below Threading <b>Welded</b> <b>81</b> Surface <b>12</b> in. RMP <input checked="" type="checkbox"/> PVC <input type="checkbox"/> Weight <b>12</b> lbs./ft. Dia. <b>5</b> in. to <b>71</b> ft. depth Wall Thickness <b>inches</b> or Dia. <b>in.</b> to <b>ft.</b> depth Gauge No. <b>250</b>		
10. Screen: Manufacturer's name <b>Sunflower</b> <b>Plastics Pipe Inc.</b> Type <b>RMP</b> Dia. <b>5</b> in. Slot/gauze <b>1/16</b> Length <b>20</b> ft. Set between <b>70</b> ft. and <b>90</b> ft. ft. and <b>90</b> ft. Gravel pack? <b>Yes</b> Size range of material <b>1-1/8</b>			11. Static water level: <b>66</b> ft. below land surface Date <b>12-1-78</b> mo./day/yr.		
12. Pumping level below land surfaces: <b>75</b> ft. after <b>1</b> hrs. pumping <b>15</b> g.p.m. ft. after <b>hrs.</b> pumping <b>g.p.m.</b> Estimated maximum yield <b>50</b> g.p.m.			13. Water sample submitted: <b>Yes</b> <input checked="" type="checkbox"/> No <input type="checkbox"/> Date <b>12-1-78</b> mo./day/yr.		
14. Well head completion: <input type="checkbox"/> Pitless adapter <b>12</b> inches above grade			15. Well grouted? <b>Yes</b> With: <input type="checkbox"/> Neat cement <input type="checkbox"/> Bentonite <input checked="" type="checkbox"/> Concrete Depth: From <b>88</b> ft. to <b>15</b> ft.		
16. Nearest source of possible contamination: ft. <b>1200</b> Direction <b>NE</b> Type <b>IGG Well</b> Well disinfected upon completion? <input checked="" type="checkbox"/> Yes <input type="checkbox"/> No			17. Pump: Manufacturer's name <b>Aermotor Windmill</b> Model number <b>85</b> HP <b>5</b> Volts <b>5</b> Length of drop pipe <b>5</b> ft. capacity <b>5</b> g.p.m. Type: <input type="checkbox"/> Submersible <input type="checkbox"/> Turbine <input type="checkbox"/> Jet <input type="checkbox"/> Reciprocating <input type="checkbox"/> Centrifugal <b>Cylind</b> <input checked="" type="checkbox"/> Other		

Forward the white, blue and pink copies to the Department of Health and Environment

Form WWC-5