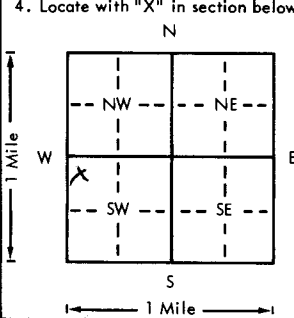


USE TYPEWRITER OR BALL POINT PEN-PRESS FIRMLY, PRINT CLEARLY.

WATER WELL RECORD
KSA 82a-1201-1215

Kansas Department of Health and Environment
Division of Environment
(Water well Contractors)
Topeka, Kansas 66620

CTB

1. Location of well:		County Hodgeman	Fraction NW 1/4 NW 1/4 SW 1/4	Section number 27	Township number T 24 S R 25	Range number 1/W	
2. Distance and direction from nearest town or city: 11 north of Dodge City, 1 west, 1/2 south, 100 yds. east			3. Owner of well: Ray Charles R.R. or street: Jetmore, Ks. 67854 City, state, zip code:				
4. Locate with "X" in section below: 			Sketch map:		6. Bore hole dia. 26 in. Completion date 12-12-76 Well depth 97 ft.		
5. Type and color of material			From	To	7. <input type="checkbox"/> Cable tool <input type="checkbox"/> Rotary <input type="checkbox"/> Driven <input type="checkbox"/> Dug <input type="checkbox"/> Hollow rod <input type="checkbox"/> Jetted <input type="checkbox"/> Bored <input checked="" type="checkbox"/> Reverse rotary		
					8. Use: <input type="checkbox"/> Domestic <input type="checkbox"/> Public supply <input type="checkbox"/> Industry <input checked="" type="checkbox"/> Irrigation <input type="checkbox"/> Air conditioning <input type="checkbox"/> Stock <input type="checkbox"/> Lawn <input type="checkbox"/> Oil field water <input type="checkbox"/> Other		
					9. Casing: Material steel Height: Above as below Threaded <input type="checkbox"/> Welded <input checked="" type="checkbox"/> Surface 12 in. RMP <input type="checkbox"/> PVC <input type="checkbox"/> Weight 36.87 lbs./ft. Dia. 16 in. to 98 ft. depth Wall Thickness: inches or Dia. <input type="checkbox"/> in. to <input type="checkbox"/> ft. depth gage No. 1250		
					10. Screen: Manufacturer's name Johnson Type galv. Dia. 16" Slot/gauze <input type="checkbox"/> Length 20 ft. Set between 67 ft. and 87 ft. Perf: 87-97 ft. and <input type="checkbox"/> ft. Gravel pack? yes Size range of material 1/2" down		
					11. Static water level: <input type="checkbox"/> mo./day/yr. 69 ft. below land surface Date 10-21-76		
					12. Pumping level below land surfaces: 87 ft. after 3 hrs. pumping 250 g.p.m. <input type="checkbox"/> ft. after <input type="checkbox"/> hrs. pumping <input type="checkbox"/> g.p.m. Estimated maximum yield 250 g.p.m.		
					13. Water sample submitted: <input type="checkbox"/> mo./day/yr. Yes <input checked="" type="checkbox"/> No Date <input type="checkbox"/>		
					14. Well head completion: <input type="checkbox"/> Pitless adapter 12 inches above grade		
					15. Well grouted? Yes With: <input type="checkbox"/> Neat cement <input type="checkbox"/> Bentonite <input checked="" type="checkbox"/> Concrete Depth: From 0 ft. to 10 ft.		
					16. Nearest source of possible contamination: N/A ft. <input type="checkbox"/> Direction <input type="checkbox"/> Type <input type="checkbox"/> Well disinfected upon completion? <input type="checkbox"/> Yes <input checked="" type="checkbox"/> No		
					17. Pump: <input type="checkbox"/> Not installed Manufacturer's name Goulds - US Pump Model number 10.110 HP 7 1/2 Volts <input type="checkbox"/> Length of drop pipe 84 ft. capacity 300 g.p.m. Type: <input type="checkbox"/> Submersible <input checked="" type="checkbox"/> Turbine <input type="checkbox"/> Jet <input type="checkbox"/> Reciprocating <input type="checkbox"/> Centrifugal <input type="checkbox"/> Other		
			(Use a second sheet if needed)				
18. Elevation: Topography: <input type="checkbox"/> Hill <input checked="" type="checkbox"/> Slope <input type="checkbox"/> Upland <input type="checkbox"/> Valley		19. Remarks: 2552 1011		20. Water well contractor's certification: This well was drilled under my jurisdiction and this report is true to the best of my knowledge and belief. Minter-Wilson Drlg. Co. 208 Business name License No. Address Box A Garden City, Ks. Signature <i>[Signature]</i> Date 5-13-77 Authorized representative			

27 250 27 1/4 NW NW Sec

Forward the white, blue and pink copies to the Department of Health and Environment

Form WWC-5

The Professionals

MINTER-WILSON DRILLING CO.
INCORPORATED

Irrigation
and Domestic
Water Systems
Complete Installation
and Repairing

Phone 276-269 • P.O. Box 493 • GARDEN CITY, KANSAS 67846

RAY CHARLES
HODGEMAN COUNTY
9-22-76

Well #2

Location: 300 Ft. south of No. 11
Static Water Level- 64

Test #12

0	1	Top soil
1	7	Brown clay
7	39	Brown clay and white rock hard
39	50	Fine to med. sand and gravel Loose
50	60	Fine to med. sand and gravel Loose Hard stks.
60	87	Fine to med. sand and gravel Loose stks. of coarse gravel
87	91	Brown and yellow clay
91	95	Shale hard