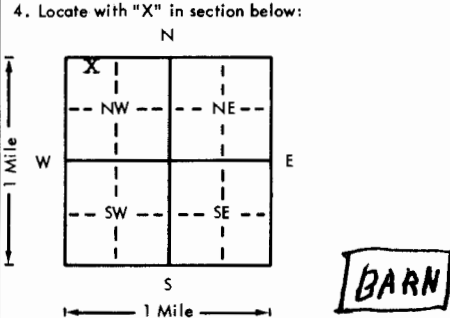



USE TYPEWRITER OR BALL POINT PEN-PRESS FIRMLY, PRINT CLEARLY.

WATER WELL RECORD
KSA 82a-1201-1215

Kansas Department of Health and Environment-Division of Environment
(Water well Contractors)
Topeka, Kansas 66620

1. Location of well:	County Hodgeman	Fraction NW 1/4 NW 1/4 NW 1/4	Section number 27	Township number T 24 S R 25	Range number EW
2. Distance and direction from nearest town or city: 8W, 10S, 1W. Street address of well location if in city: of Jetmore			3. Owner of well: Leonard Harms R.R. or street: City, state, zip code: Jetmore, Kansas 67854		
4. Locate with "X" in section below: 			Sketch map: 		
5. Type and color of material			From	To	6. Bore hole dia. 8 in. Completion date 10-8-80 Well depth 95 ft.
Topsoil			0	3	7. <input checked="" type="checkbox"/> Cable tool <input checked="" type="checkbox"/> Rotary <input type="checkbox"/> Driven <input type="checkbox"/> Dug <input type="checkbox"/> Hollow rod <input type="checkbox"/> Jetted <input type="checkbox"/> Bored <input type="checkbox"/> Reverse rotary
Clay White			3	22	8. Use: <input checked="" type="checkbox"/> Domestic <input type="checkbox"/> Public supply <input type="checkbox"/> Industry <input type="checkbox"/> Irrigation <input type="checkbox"/> Air conditioning <input type="checkbox"/> Stock <input type="checkbox"/> Lawn <input type="checkbox"/> Oil field water <input type="checkbox"/> Other
Limestone			22	56	9. Casing: Material Plts Height: Above or below Threaded <input type="checkbox"/> Welded <input checked="" type="checkbox"/> Surface 12 in. RMP <input checked="" type="checkbox"/> PVC <input type="checkbox"/> Weight 2 lbs./ft. Dia. 5 in. to 75 ft. depth Wall Thickness: inches or Dia. <input type="checkbox"/> in. to <input type="checkbox"/> ft. depth gage No. 250
Clay Brown			56	76	10. Screen: Manufacturer's name Jess & Lowell Type RMP Dia. 5 Slot gauze (1/16) Length 20 Set between 75 ft. and 95 ft. <input type="checkbox"/> ft. and <input type="checkbox"/> ft. Gravel pack? Yes Size range of material 1/8
Sand			76	82	11. Static water level: 72 ft. below land surface Date 10-3-80 mo./day/yr.
Clay			82	85	12. Pumping level below land surfaces: 80 ft. after 1 hrs. pumping 15 g.p.m. <input type="checkbox"/> ft. after <input type="checkbox"/> hrs. pumping <input type="checkbox"/> g.p.m. Estimated maximum yield 22 g.p.m.
Sand			85	94	13. Water sample submitted: <input type="checkbox"/> Yes <input checked="" type="checkbox"/> No Date <input type="checkbox"/> mo./day/yr.
Clay Yellow			94	95	14. Well head completion: <input checked="" type="checkbox"/> Pitless adapter 12 Inches above grade
(Use a second sheet if needed)					15. Well grouted? Yes With: <input type="checkbox"/> Neat cement <input type="checkbox"/> Bentonite <input checked="" type="checkbox"/> Concrete Depth: From 5 ft. to 15 ft.
18. Elevation:			16. Nearest source of possible contamination: ft. 250 Direction SW Type Well Well disinfected upon completion? <input checked="" type="checkbox"/> Yes <input type="checkbox"/> No		
19. Remarks:			17. Pump: <input type="checkbox"/> Not installed Manufacturer's name Goulds Model number 10 ej HP 1/2 Volts 230 Length of drop pipe 90 ft. capacity 12 g.p.m. Type: <input checked="" type="checkbox"/> Submersible <input type="checkbox"/> Turbine <input type="checkbox"/> Jet <input type="checkbox"/> Reciprocating <input type="checkbox"/> Centrifugal <input type="checkbox"/> Other		
Topography: <input type="checkbox"/> Hill <input type="checkbox"/> Slope <input checked="" type="checkbox"/> Upland <input type="checkbox"/> Valley			20. Water well contractor's certification: This well was drilled under my jurisdiction and this report is true to the best of my knowledge and belief. Knoefler Bros. Drilling Business name Jetmore License No. 130 Address Jetmore Signed Dale Knoefler Date 10-16-80 Authorized representative		

24 25 27 28 29 

Forward the white, blue and pink copies to the Department of Health and Environment

Form WWC-5