

DODGE CITY NE

USE TYPEWRITER OR BALL POINT PEN-PRESS FIRMLY, PRINT CLEARLY.

T R EW sec 1/4 1/4 1/4 No.

WATER WELL RECORD
KSA 82a-1201-1215

Kansas State Dept. Of Health
(Water Well Contractors)
Forbes-Bldg. 740
Topeka, Kansas 66620


ADA

1 Location of well:	County Hodgeman	Township name South Roscoe	Section number 33	Town number T-24-S	Range number R-25-W
---------------------	---------------------------	--------------------------------------	-----------------------------	------------------------------	-------------------------------

Distance and direction from nearest town or city: **9 1/2 north and 1 mi west Dodge City, Ks**

3 Owner of well: **Marvin Eichman**

Street address of well location if in city: _____ Address: **Dodge City, Kansas**

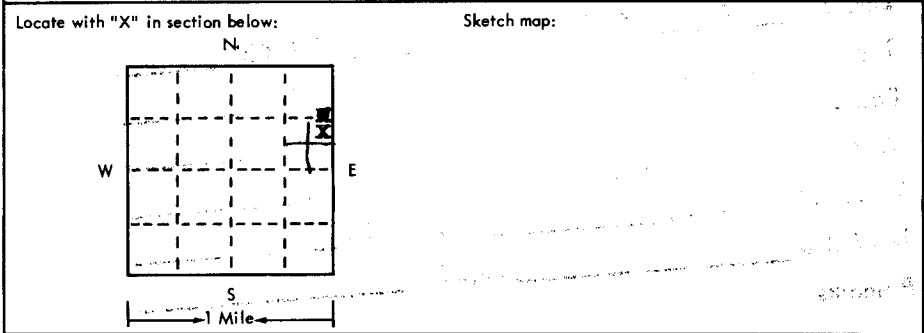

4 Well depth: **375** ft. Date of completion **9-8-75**
Well diameter **26** in.

5 Cable tool Rotary Driven Dug
 Hollow rod Jetted Bored Reverse rotary

6 Use: Domestic Public supply Industry
 Irrigation Air conditioning Commercial
 Test well

7 Casing: Material **Metal** Weight: above/below
Threaded Welded Surface **1 3/8** Dia. **30.30** lbs./ft.
Diam. **16** in. to **375** ft. depth Drive shoe? Yes No
_____ in. to _____ ft. depth

2 Type and color of material	From	To
Surface	0	3
Caleche clay	3	10
" " with sandrock mixed	10	25
Sand and gravel	25	32
Yellow clay with rock layers	(32)	37
Black, blue & gray shale with rock layers	37	210
Lite sandstone	210	236
Shale with rock layers	236	250
Sandstone	250	260
Gray shale with rock layers	260	295
Good sandstone	295	360
Sandstone with 30% shale mixed	360	375
Shale	375	440
BRock 32'		
CRETACEOUS		
(use a second sheet if needed) WELL		

8 Screen: Manufacturer **W.A. Brown**
Type **Free flow** Dia. **2 1/2**
Slot/gauze **78** Length **276**
Set between **206** ft. and **271** ft. **291-373**
Fittings: Gravel pack Yes No Size range of material **1/2** down

9 Static water level: **180** ft. below land surface Date **9-8-75**

10 Pumping level below land surfaces:
280 ft. after **3** hrs. pumping **750** g.p.m.
320 ft. after **3** hrs. pumping **950** g.p.m.
Estimated maximum yield **1000** g.p.m.

11 Water sample submitted: Yes No Date _____

12 Well head completion: Pitless adapter Inches above grade

13 Well grouted? Yes No
 Neat cement Bentonite _____
Depth: From **0** ft. to **10** ft.

14 Nearest source of possible contamination: **NA**
ft. _____ Direction _____ Type _____
Well disinfected upon completion? Yes No

15 Pump: Not installed
Manufacturer's name **Gould's 8" 105 stage**
Model number **12320** HP **150** Volts _____
Length of drop pipe **360** ft. capacity **20** g.p.m.
Type: Submersible Turbine
 Jet Reciprocating
 Centrifugal Other **80 PSI**

16 Remarks: elevation

Topography:
 Hill **2527**
 Slope **32**
 Upland **2495**
 Valley **TOPO**

17 Water well contractor's certification:
This well was drilled under my jurisdiction and this report is true to the best of my knowledge and belief.
Ace-Hi International Inc. 190
Business name License No. _____
Address **Box 1442, Dodge City, Kan**
Signed **Paul G. Jittel** Date **9-29-75**
Authorized representative