DODGE CITY NE

USE TYPEWRITER OR BALL POINT PEN-PRESS FIRMLY, PRINT CLEARLY.

WATER WELL RECORD
KSA 82a-1201-1215

Kansas Department of Health and Environment-Division of Environment
(Water well Contractors)
Topeka, Kansas 66620

CCC

1. Location of well:	County	Fraction	Section number	Township number	Range number
	Hodgeman	SW 1/4 SW 1/4 SW 1/4	36	T 24 S	R 25 E (W)

2. Distance and direction from nearest town or city: 7W, 12S.
Street address of well location if in city: of Jetmore

3. Owner of well: Bill Maskus
R.R. or street:
City, state, zip code: Jetmore, Kansas 67854

4. Locate with "X" in section below:

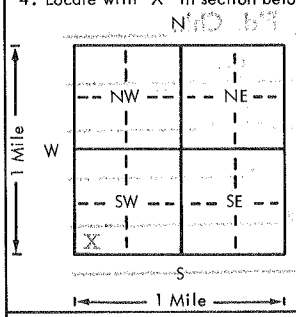

Sketch map:

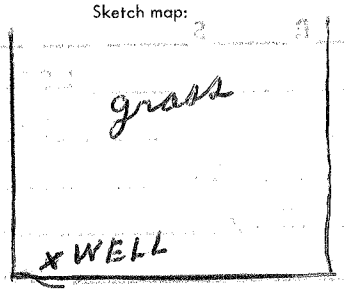

6. Bore hole dia. 8 in. Completion date
Well depth 26½ ft. 4-20-77

7. __ Cable tool X Rotary __ Driven __ Dug
__ Hollow rod __ Jetted __ Bored __ Reverse rotary

8. Use: __ Domestic __ Public supply __ Industry
__ Irrigation __ Air conditioning X Stock
__ Lawn __ Oil field water __ Other

9. Casing: Material pits Height: Above or below
Threaded __ Welded gl Surface 18 in.
RMP X PVC __ Weight __ lbs./ft.
Dia. 5 in. to 11½ ft. depth Wall Thickness: inches or
Dia. __ in. to __ ft. depth gage No. 250

10. Screen: Manufacturer's name Sunflower Plastics Pipe Inc.
Type RMP Dia. 5" mk
Slot/gauze 1/16 Length 15ft
Set between 11½ ft. and 26 ft.
__ ft. and __ ft.
Gravel pack? Yes Size range of material 1-1/8

11. Static water level: mo./day/yr.
12 ft. below land surface Date 4-15-77

12. Pumping level below land surfaces:
15 ft. after 1 hrs. pumping 10 g.p.m.
__ ft. after __ hrs. pumping __ g.p.m.
Estimated maximum yield 20 g.p.m.

13. Water sample submitted: mo./day/yr.
__ Yes X No Date

14. Well head completion:
__ Pitless adapter 18 Inches above grade

15. Well grouted? Yes
With: __ Neat cement __ Bentonite X Concrete
Depth: From 0 ft. to 10 ft.

16. Nearest source of possible contamination:
ft. 150 Direction S Type Well
Well disinfected upon completion? X Yes __ No

17. Pump: __ Not installed
Manufacturer's name WindMill
Model number __ HP __ Volts __
Length of drop pipe 21 ft. capacity 4 g.p.m.
Type:
__ Submersible __ Turbine
__ Jet __ Reciprocating
__ Centrifugal X Other

5. Type and color of material	From	To
Topsoil	0	3
Clay & White Rock	3	14
Sand	14	26
BROCK 26'		
12		
14' sat thick		
in Alluvium		
(Use a second sheet if needed)		

18. Elevation:
Topography:
__ Hill
__ Slope
__ Upland
X Valley

19. Remarks:
Concrete slab was installed
TOPO 2453

20. Water well contractor's certification:
This well was drilled under my jurisdiction and this report is true to the best of my knowledge and belief.
Business name Knoefler Bros. Drilling License No. 130
Address Jetmore
Signed Dale Knoefler Date 5-27-77
Authorized representative

T 24 R 25 E (W) Sec 36 1/4 SW 1/4 SW 1/4 SW 1/4

Forward the white, blue and pink copies to the Department of Health and Environment

Form WWC-5

MI-1023