USE TYPEWRITER OR BALL POINT PEN-PRESS FIRMLY, PRINT CLEARLY.

WATER WELL RECORD
KSA 82a-1201-1215

DODGE C NW

Kansas Department of Health and Environment-Division of Environment
(Water well Contractors)
Topeka, Kansas 66620

DBB

1. Location of well:	County	Fraction	Section number	Township number	Range number
	Hodgeman	NW 1/4 NW 1/4 SE 1/4	15	T 24 S	R 26 E/W

2. Distance and direction from nearest town or city: 13 miles West and 8 miles South of Jetmore, Kansas on highway
Street address of well location if in city: 156

3. Owner of well: William Setzkorn
R.R. or street: North Star Route
City, state, zip code: Dodge City, Kansas 67801

4. Locate with "X" in section below:

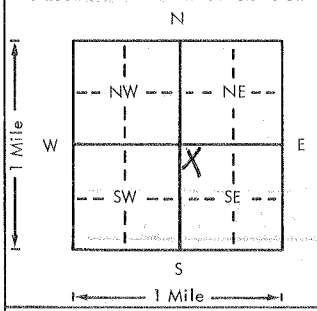

Sketch map:

6. Bore hole dia. 8 in. Completion date
Well depth 52 ft. 8-14-78

7. ___ Cable tool XX Rotary ___ Driven ___ Dug
___ Hollow rod ___ Jetted ___ Bored ___ Reverse rotary

8. Use: ___ Domestic ___ Public supply ___ Industry
___ Irrigation ___ Air conditioning XX Stock
___ Lawn ___ Oil field water ___ Other

9. Casing: Material RMP
Threaded ___ Welded ___
RMP XX PVC ___
Dia. 5 in. to 52 ft. depth
Dia. ___ in. to ___ ft. depth
Height: Above ~~or below~~
Surface 12 in.
Weight ___ lbs./ft.
Wall Thickness: inches or gage No. 250

5. Type and color of material	From	To
Top soil & clay	0	15
Clay & white rock(loose) & medium sand	15	30
Medium sand	30	45
Medium sand & clay, Blue shale	45	52

(Use a second sheet if needed)

BR 48 48/25 23' cat thick

TOPO 2583 48/2535 1M 08

2 56 3 2 9 2 58

10. Screen: Manufacturer's name Sunflower
Type RMP Dia. 5"
Slot ~~gauze~~ 1/8" Length 20 ft.
Set between 30 ft. and 50 ft.
___ ft. and ___ ft.
Gravel pack? yes Size range of material 4"

11. Static water level: mo./day/yr.
25 ft. below land surface Date 8-14-78

12. Pumping level below land surfaces:
___ ft. after ___ hrs. pumping ___ g.p.m.
___ ft. after ___ hrs. pumping ___ g.p.m.
Estimated maximum yield 10 g.p.m.

13. Water sample submitted: mo./day/yr.
___ Yes XX No Date

14. Well head completion: none
___ Pitless adapter ___ Inches above grade

15. Well grouted? yes
With: ___ Neat cement XX Bentonite ___ Concrete
Depth: From 0 ft. to 15 ft.

16. Nearest source of possible contamination: none
ft. ___ Direction ___ Type
Well disinfected upon completion? XX Yes ___ No

17. Pump: Windmill XX Not installed
Manufacturer's name
Model number ___ HP ___ Volts
Length of drop pipe ___ ft. capacity ___ g.p.m.
Type:
___ Submersible ___ Turbine
___ Jet ___ Reciprocating
___ Centrifugal ___ Other

T 24 S R 26 E/W Sec 15 1/4 1/4 1/4 1/4

18. Elevation:
Topography:
XX Hill
___ Slope
___ Upland
___ Valley

19. Remarks:
in the middle of a pasture.

20. Water well contractor's certification:
This well was drilled under my jurisdiction and this report is true to the best of my knowledge and belief.
Joe's Well Service 179
Business name License No.
Address Box 174 Cimarron, Ks.
Signed Larry Crick 10-2-78 Date
Authorized representative

Forward the white, blue and pink copies to the Department of Health and Environment

Form WWC-5

MI-1023