USE TYPEWRITER OR BALL POINT PEN-PRESS FIRMLY, PRINT CLEARLY.

WATER WELL RECORD
KSA 82a-1201-1215

Kansas Department of Health and Environment-Division of Environment
(Water well Contractors)
Topeka, Kansas 66620

1. Location of well:	County	Fraction	Section number	Township number	Range number
	Gray	3E 1/4 SE 1/4 SW 1/4	14	T 24 S	R 27 E/(W)

2. Distance and direction from nearest town or city: 3E, 7S, 1½W
Street address of well location if in city: of Kalvesta,

3. Owner of well: Geo Nash
R.R. or street:
City, state, zip code: Cimarron, Kansas 67835

4. Locate with "X" in section below:

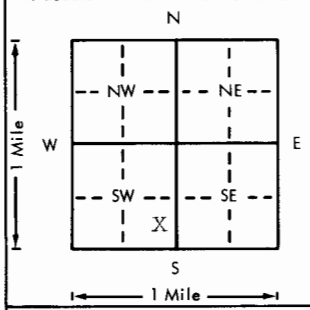

Sketch map:

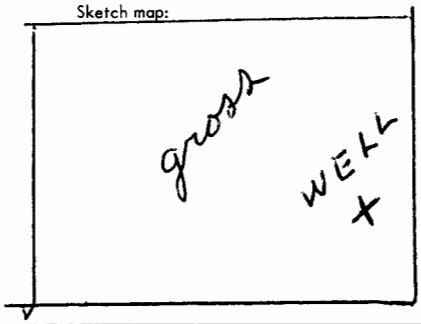

6. Bore hole dia. 8 in. Completion date
Well depth 57 ft. 9-28-77

7. __ Cable tool X Rotary __ Driven __ Dug
__ Hollow rod __ Jetted __ Bored __ Reverse rotary

8. Use: __ Domestic __ Public supply __ Industry
__ Irrigation __ Air conditioning X Stock
__ Lawn __ Oil field water __ Other

9. Casing: Material plts Height: (Above) or below
Threaded ___ Welded gl Surface 12 in.
RMP ___ PVC ___ Weight ___ lbs./ft.
Dia. 5 in. to 42 ft. depth Wall Thickness: inches or
Dia. ___ in. to ___ ft. depth gage No. .250

10. Screen: Manufacturer's name Sunflower Plastics Pipe, Inc.
Type RMP Dia. 5 in
(Slot)/gauze 1/16 Length 15
Set between 42 ft. and 57 ft.
___ ft. and ___ ft.
Gravel pack? Yes Size range of material 1/ 1/3

11. Static water level:
27 ft. below land surface Date 9-20-77 mo./day/yr.

12. Pumping level below land surfaces:
30 ft. after 1 hrs. pumping 10 g.p.m.
___ ft. after ___ hrs. pumping ___ g.p.m.
Estimated maximum yield 20 g.p.m.

13. Water sample submitted: mo./day/yr.
___ Yes X No Date

14. Well head completion:
___ Pitless adapter 12 Inches above grade

15. Well grouted? Yes
With: ___ Neat cement ___ Bentonite X Concrete
Depth: From 0 ft. to 12 ft.

16. Nearest source of possible contamination:
ft. ___ Direction none Type
Well disinfected upon completion? X Yes ___ No

17. Pump: ___ Not installed
Manufacturer's name Aermotor Mill
Model number ___ HP ___ Volts ___
Length of drop pipe 40 ft. capacity 5 g.p.m.
Type:
___ Submersible ___ Turbine
___ Jet ___ Reciprocating
___ Centrifugal Cylinder Other

5. Type and color of material	From	To
Topsoil	0	3
White clay	3	45
sand	45	55
yellow clay	55	57
(Use a second sheet if needed)		

18. Elevation:

Topography:
___ Hill
X Slope
___ Upland
___ Valley

19. Remarks:
Concrete slab was installed

20. Water well contractor's certification:
This well was drilled under my jurisdiction and this report is true to the best of my knowledge and belief.
Knoefler Bros. Drilling
Business name License No.
Address Jetmore, Ks 130
Signed Dale Knoefler Date 10-19-77
Authorized representative

T 24 R 27 E/W Sec 14 1/4 1/4 1/4 SE SW

Forward the white, blue and pink copies to the Department of Health and Environment

Form WWC-5

M1-1023