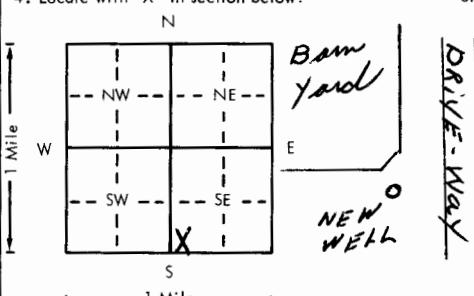


USE TYPEWRITER OR BALL  
POINT PEN-PRESS FIRMLY,  
PRINT CLEARLY.

WATER WELL RECORD  
KSA 82a-1201-1215

Kansas Department of Health and  
Environment-Division of Environment  
(Water well Contractors)  
Topeka, Kansas 66620

1. Location of well:	County Gray	Fraction SW 1/4 SW 1/4 SE 1/4	Section number 8	Township number T 24	Range number S R 29	X/W	
2. Distance and direction from nearest town or city:	7 miles North & 1 1/2 miles east of Charleston, Kansas		3. Owner of well:	Vern Markel			
Street address of well location if in city:		R.R. or street: City, state, zip code: Ingalls, Kansas 67853					
4. Locate with "X" in section below:	Sketch map: 		6. Bore hole dia. 8 in. Completion date _____ Well depth 190 ft. 10-10-78				
5. Type and color of material	From	To	7. <input checked="" type="checkbox"/> Cable tool <input checked="" type="checkbox"/> Rotary <input type="checkbox"/> Driven <input type="checkbox"/> Dug <input type="checkbox"/> Hollow rod <input checked="" type="checkbox"/> Jetted <input type="checkbox"/> Bored <input type="checkbox"/> Reverse rotary				
Top soil & clay	0	15	8. Use: <input checked="" type="checkbox"/> Domestic <input type="checkbox"/> Public supply <input type="checkbox"/> Industry <input type="checkbox"/> Irrigation <input type="checkbox"/> Air conditioning <input type="checkbox"/> Stock <input type="checkbox"/> Lawn <input type="checkbox"/> Oil field water <input type="checkbox"/> Other				
Clay	15	45	9. Casing: Material <input checked="" type="checkbox"/> RMP <input type="checkbox"/> Threaded <input type="checkbox"/> Welded <input type="checkbox"/> Surface Height: Above <input checked="" type="checkbox"/> below RMP <input checked="" type="checkbox"/> PVC <input type="checkbox"/> Weight _____ lbs./ft. Dia. 5 in. to 190 ft. depth Wall Thickness: inches or Dia. _____ in. to _____ ft. depth gage No. 250				
Clay & fine sand	45	60	10. Screen: Manufacturer's name Jess & Lowell				
Fine to medium sand	60	75	Type <input checked="" type="checkbox"/> RMP Dia. 5" Slot <input checked="" type="checkbox"/> 1/8" Length 20 ft. Set between 172 ft. and 192 ft. ft. and _____ ft. Gravel pack? <input checked="" type="checkbox"/> Yes Size range of material <input type="checkbox"/> ft.				
Medium sand & clay	75	90	11. Static water level: 100 ft. below land surface Date 10-10-78				
Clay & fine sand layers	90	120	12. Pumping level below land surfaces: 105 ft. after 2 hrs. pumping 35 g.p.m. ft. after _____ hrs. pumping _____ g.p.m. Estimated maximum yield 50 g.p.m.				
Fine sand	120	135	13. Water sample submitted: Yes <input checked="" type="checkbox"/> No Date				
Fine sand & clay	135	165	14. Well head completion: <input checked="" type="checkbox"/> Pitless adapter 12 Inches above grade				
Medium to coarse sand	165	180	15. Well grouted? <input checked="" type="checkbox"/> Yes With: <input checked="" type="checkbox"/> Neat cement <input type="checkbox"/> Bentonite <input type="checkbox"/> Concrete Depth: From 7 ft. to 20 ft.				
Medium to coarse sand & clay (6ft.)	180	195	16. Nearest source of possible contamination: Barn ft. 25 Direction North Type <input checked="" type="checkbox"/> Yard Well disinfected upon completion? <input checked="" type="checkbox"/> Yes <input type="checkbox"/> No				
(Use a second sheet if needed)		17. Pump: Not installed Manufacturer's name <input checked="" type="checkbox"/> Flint & Walling Model number 15BK12 HP 1 1/2 Volts 230 Length of drop pipe 150 ft. capacity 20 g.p.m. Type: <input checked="" type="checkbox"/> Submersible <input type="checkbox"/> Turbine <input type="checkbox"/> Jet <input type="checkbox"/> Reciprocating <input type="checkbox"/> Centrifugal <input type="checkbox"/> Other					
18. Elevation:	19. Remarks: Well has good drainage to the West						20. Water well contractor's certification: This well was drilled under my jurisdiction and this report is true to the best of my knowledge and belief. Joe's Well Service 179 Business name <input type="checkbox"/> Address Box 174 Cimarron, Ks. License No. _____ Signed <input checked="" type="checkbox"/> Larry Creek 11-3-78 Date _____ Authorized representative