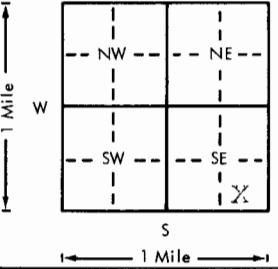


USE TYPEWRITER OR BALL
POINT PEN-PRESS FIRMLY,
PRINT CLEARLY.

WATER WELL RECORD
KSA 82a-1201-1215

Kansas Department of Health and
Environment-Division of Environment
(Water well Contractors)
Topeka, Kansas 66620

1. Location of well:	County Gray	Fraction SE 1/4	1/4	1/4	Section number 18	Township number 24	S R	Range number 29	E/W	
2. Distance and direction from nearest town or city: 1/2 mi W., 6 mi N and 1/2 mi E. of Street address of well location if in city: Charleston, Ks.					3. Owner of well: Leon Nicholson					
4. Locate with "X" in section below: N					Sketch map: <i>First Well Completed</i> <i>1st Well Measured</i>					
					6. Bore hole dia. <u>26</u> in. Completion date <u>4/28/77</u> Well depth <u>216</u> ft.					
					7. <input type="checkbox"/> Cable tool <input type="checkbox"/> Rotary <input type="checkbox"/> Driven <input type="checkbox"/> Dug <input type="checkbox"/> Hollow rod <input type="checkbox"/> Jetted <input type="checkbox"/> Bored <input checked="" type="checkbox"/> Reverse rotary					
					8. Use: <input type="checkbox"/> Domestic <input type="checkbox"/> Public supply <input type="checkbox"/> Industry <input checked="" type="checkbox"/> Irrigation <input type="checkbox"/> Air conditioning <input type="checkbox"/> Stock <input type="checkbox"/> Lawn <input type="checkbox"/> Oil field water <input type="checkbox"/> Other					
					9. Casing: Material <u>Steel</u> Height: Above or below Threaded <input type="checkbox"/> Welded <input checked="" type="checkbox"/> Surface <u>12-17</u> in. RMP <input type="checkbox"/> PVC <input type="checkbox"/> Weight <u>31</u> lbs./ft. Dia. <u>16</u> in. to <u>216</u> in. Wall thickness: inches or Dia. <input type="checkbox"/> in. to <input type="checkbox"/> ft. depth gage No. <u>188</u>					
5. Type and color of material See Attachments					From	To	10. Screen: Manufacturer's name <u>Johnson</u> <u>Continuous</u> Type <u>Slotted</u> Dia. <u>16"</u> Slot/gauze <u>.100</u> Length <u>50'</u> Set between <u>120'</u> ft. and <u>170'</u> ft. <u>Yes</u> ft. and <u>1</u> ft. Gravel pack? <u>Yes</u> Size range of material <u>1/4-1/8"</u>			
					11. Static water level: <u>111</u> ft. below land surface Date <u>4/29/77</u>					
					12. Pumping level below land surfaces: <u>202</u> ft. after <input type="checkbox"/> hrs. pumping <u>1030</u> g.p.m. <input type="checkbox"/> ft. after <input type="checkbox"/> hrs. pumping <input type="checkbox"/> g.p.m. Estimated maximum yield <input type="checkbox"/> g.p.m.					
					13. Water sample submitted: <input type="checkbox"/> mo./day/yr. <u>Yes</u> <input checked="" type="checkbox"/> No Date <input type="checkbox"/>					
					14. Well head completion: <input type="checkbox"/> Pitless adapter <u>17</u> inches above grade					
					15. Well grouted? <u>Yes</u> With: <input type="checkbox"/> Neat cement <input checked="" type="checkbox"/> Bentonite <input type="checkbox"/> Concrete Depth: From <u>0</u> ft. to <u>10</u> ft.					
					16. Nearest source of possible contamination: <u>None</u> ft. <input type="checkbox"/> Direction <input type="checkbox"/> Type <u>Observed</u> Well disinfected upon completion? <input type="checkbox"/> Yes <input checked="" type="checkbox"/> No					
					17. Pump: <input checked="" type="checkbox"/> Not installed Manufacturer's name <input type="checkbox"/> Model number <input type="checkbox"/> HP <input type="checkbox"/> Volts <input type="checkbox"/> Length of drop pipe <input type="checkbox"/> ft. capacity <input type="checkbox"/> g.p.m. Type: <input type="checkbox"/> Submersible <input type="checkbox"/> Turbine <input type="checkbox"/> Jet <input type="checkbox"/> Reciprocating <input type="checkbox"/> Centrifugal <input type="checkbox"/> Other					
(Use a second sheet if needed)					18. Elevation: <u>X</u> Flat Topography: <input type="checkbox"/> Hill <input type="checkbox"/> Slope <input type="checkbox"/> Upland <input type="checkbox"/> Valley					19. Remarks:
					20. Water well contractor's certification: This well was drilled under my jurisdiction and this report is true to the best of my knowledge and belief. <u>Henkle Drilling & Supply</u> <u>145</u> Business name <input type="checkbox"/> License No. <input type="checkbox"/> Address <u>Box 639, Garden City, KS</u> Signed <u>L. Bothwell</u> Date <u>5/5/77</u> Authorized representative <input type="checkbox"/>					

DRILLERS TEST LOG

CUSTOMERS NAME Leon Nicholson DATE 4-8-77
STREET ADDRESS _____ TEST # 13 E. LOG Yes
CITY & STATE Ingalls, KS DRILLER Lee
COUNTY Gray QUARTER SE SECTION 18 TOWNSHIP 24 RANGE 29

LOCATION 50' E of Test #12

WELL LOCATION

GARDEN CITY, KS
Phone 276-3278

WEST HOMES & C

TEST HOLES * * * * * IRRIGATION & INDUSTRIAL WELLS * * * * * STOCK WELLS

HENKLE DRILLING & SUPPLY CO., INC.

IRRIGATION HEADQUARTERS

SUBLETTE, KS


Phone 675-4311

TEST HOLE MAP

HENKLE DRILLING & SUPPLY CO., INC.

CUSTOMER Leon Nicholson
ADDRESS Ingalls, KS.
DATE 4/4/77

TEST NO. 6, 7, 8, 9, 10, 11, 12, 13, 14, 15, 16,
COUNTY Gray 17, 18, & 19.
Qtr. SE Sec. 15 Twp. 24 Rg. 29

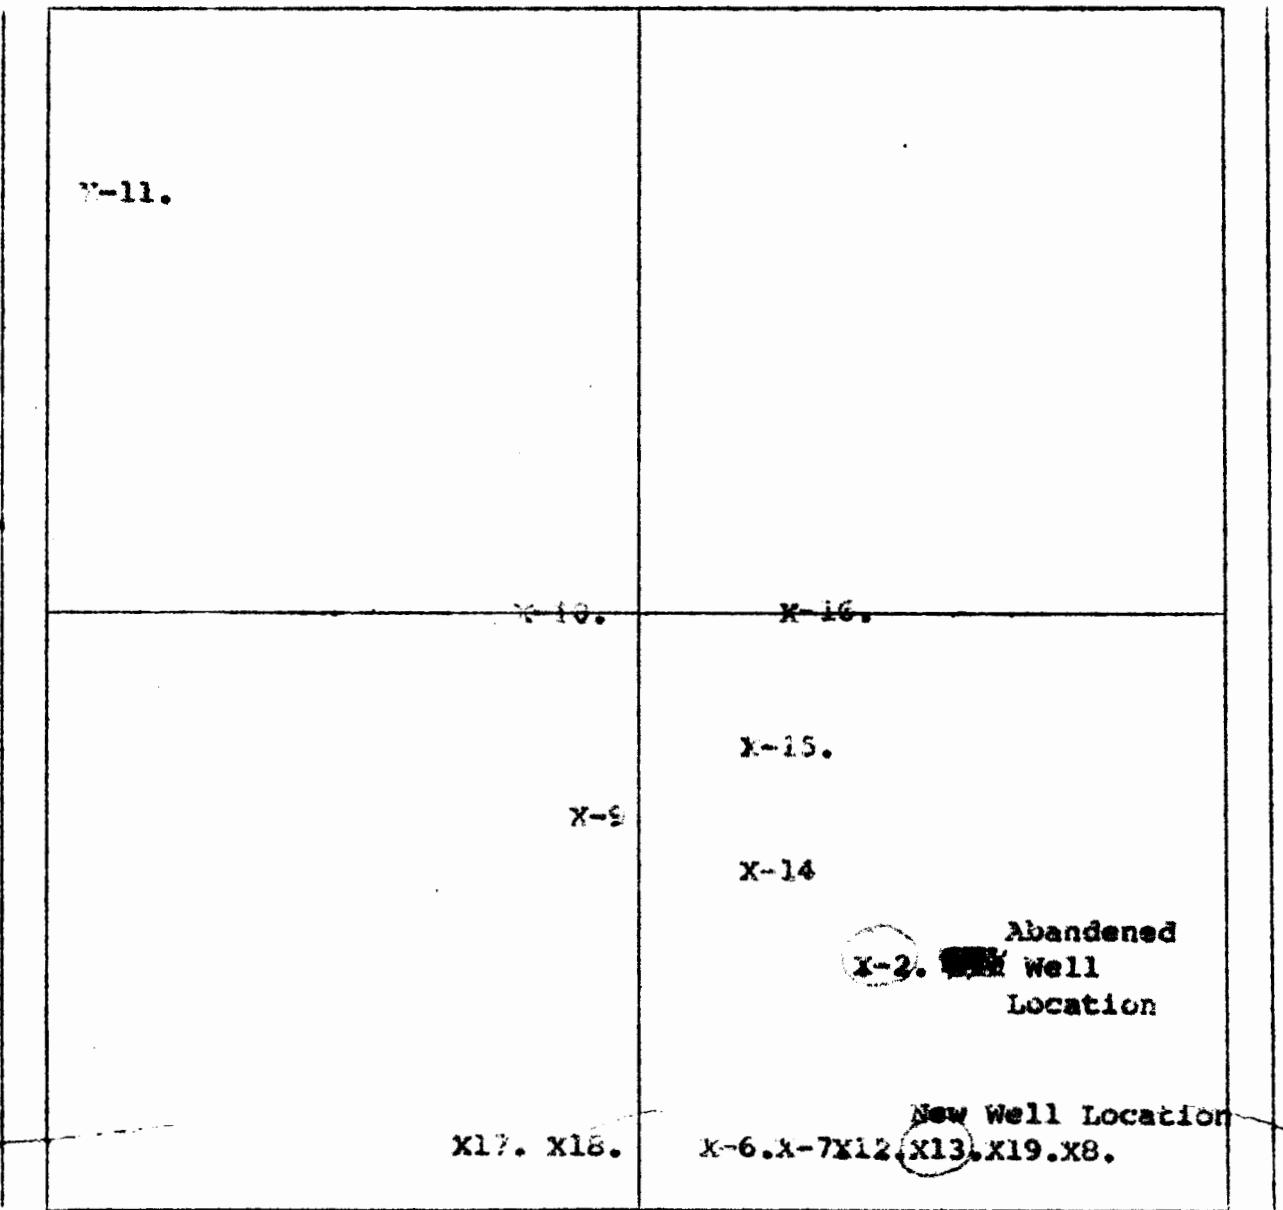

HENKLE DRILLING & SUPPLY CO., INC.
DRILLER Tom