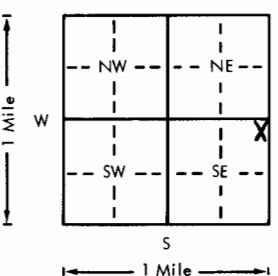
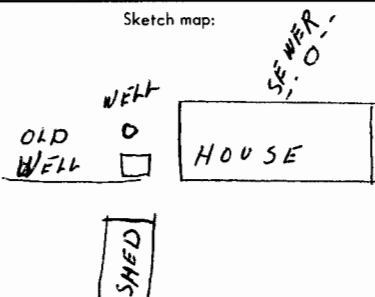


USE TYPEWRITER OR BALL
POINT PEN-PRESS FIRMLY,
PRINT CLEARLY.

WATER WELL RECORD
KSA 82a-1201-1215

Kansas Department of Health and
Environment-Division of Environment
(Water well Contractors)
Topeka, Kansas 66620

1. Location of well:		County Gray	Fraction NE 1/4 NE 1/4 SE 1/4	Section number 19	Township number T 24 S R 29 E	Range number 29
2. Distance and direction from nearest town or city: 6 1/2 miles north 1 mile east and 1/2 mile south of Charleston, Kansas				3. Owner of well: Robert Maxwell R.R. or street: City, state, zip code: Ingalls, Kansas 67853		
4. Locate with "X" in section below:		Sketch map:		6. Bore hole dia. 8 in. Completion date 6-20-77 Well depth 235 ft.		
				7. <input checked="" type="checkbox"/> Cable tool <input checked="" type="checkbox"/> Rotary <input type="checkbox"/> Driven <input type="checkbox"/> Dug <input type="checkbox"/> Hollow rod <input type="checkbox"/> Jetted <input type="checkbox"/> Bored <input type="checkbox"/> Reverse rotary		
5. Type and color of material		From		To		8. Use: <input checked="" type="checkbox"/> Domestic <input type="checkbox"/> Public supply <input type="checkbox"/> Industry <input type="checkbox"/> Irrigation <input type="checkbox"/> Air conditioning <input type="checkbox"/> Stock <input type="checkbox"/> Lawn <input type="checkbox"/> Oil field water <input type="checkbox"/> Other
Top soil & clay		0		15		9. Casing: Material RMP Height: Above ground 12 in. Threaded <input type="checkbox"/> Welded <input type="checkbox"/> Surface 12 in. RMP XX PVC <input type="checkbox"/> Weight 12 lbs./ft. Dia. 5 in. to 235 ft. depth Wall Thickness: inches or Dia. 5 in. to 235 ft. depth gage No. 250
Clay & cleecy layers		15		30		10. Screen: Manufacturer's name Sunflower Type RMP Dia. 5 in. Slot/gauge 1/8 in. Length 20 ft. Set between 210 ft. and 230 ft. ft. and 230 ft. Gravel pack? yes Size range of material 1/4 in.
Clay & mixed sand		30		45		11. Static water level: 127 ft. below land surface Date 6-20-77 mo./day/yr.
Medium sand & clay layers		45		60		12. Pumping level below land surfaces: 135 ft. after 1 hrs. pumping 30 g.p.m. ft. after 1 hrs. pumping 30 g.p.m. Estimated maximum yield 50 g.p.m.
Medium sand, clay & sand rock		60		90		13. Water sample submitted: 127 ft. below land surface Date 6-20-77 mo./day/yr.
Clay, medium sand & sand rock layers		90		105		14. Well head completion: XX Pitless adapter 12 inches above grade
Sand & clay mixed, sand rock layers		105		120		15. Well grouted? yes With: <input checked="" type="checkbox"/> Neat cement <input type="checkbox"/> Bentonite <input type="checkbox"/> Concrete Depth: From 7 ft. to 17 ft.
Medium sand & clay		120		150		16. Nearest source of possible contamination: ft. 125 Direction NE Type Sewer Well disinfected upon completion? XX Yes <input type="checkbox"/> No
Medium sand, clay & sand rock		150		180		17. Pump: Manufacturer's name Flint & Walling Model number 15BK12 HP 1 1/2 Volts 230 Length of drop pipe 185 ft. capacity 15 g.p.m. Type: <input checked="" type="checkbox"/> Submersible <input type="checkbox"/> Turbine <input type="checkbox"/> Jet <input type="checkbox"/> Reciprocating <input type="checkbox"/> Centrifugal <input type="checkbox"/> Other
Clay & medium sand		180		210		20. Water well contractor's certification: This well was drilled under my jurisdiction and this report is true to the best of my knowledge and belief. Joe's Well Service 179 Business name License No. Address Box 174 Cimarron, Ks. Signed Larry Crick 10-15-77 Authorized representative Date
Medium sand & clay		210		240		
Medium sand, clay & shale		240		255		
(Use a second sheet if needed)						
18. Elevation:		19. Remarks:		20. Water well contractor's certification:		
Topography: <input type="checkbox"/> Hill <input type="checkbox"/> Slope <input checked="" type="checkbox"/> Upland <input type="checkbox"/> Valley						

Forward the white, blue and pink copies to the Department of Health and Environment

Form WWC-5