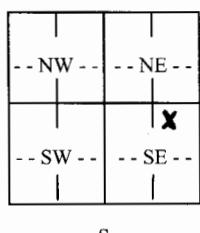
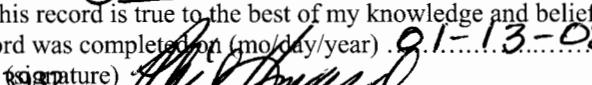


WATER WELL RECORD

Form WWC-5

Division of Water Resources; App. No.

Markel #1A
2008 0034

1 LOCATION OF WATER WELL: County: Gray		Fraction C $\frac{1}{4}$ NE $\frac{1}{4}$ $\frac{1}{4}$	Section Number 8	Township Number 24	Range Number 29 E/W	
Distance and direction from nearest town or city street address of well if located within city? Garden City: Hwy 50 East to Pole Line Rd. 10 E 1 N 2 E and .4 N&W into						
2 WATER WELL OWNER: RR#, St. Address, Box # : City, State, ZIP Code :		L D Drilling Inc RR 1, Box 183B Great Bend, Ks 67530				
3 LOCATE WELL'S LOCATION WITH AN "X" IN SECTION BOX: N  W E S		4 DEPTH OF COMPLETED WELL 180 ft.				
Depth(s) Groundwater Encountered (1) 100 ft. (2) ft. (3) ft. WELL'S STATIC WATER LEVEL 100 ft. below land surface measured on mo/day/yr. 01-13-08						
Pump test data: Well water was 110 ft. after 1 hours pumping. 100 gpm Est. Yield 100 gpm: Well water was ft. after hours pumping gpm						
WELL WATER TO BE USED AS: 5 Public water supply 8 Air conditioning 11 Injection well 1 Domestic 3 Feedlot 6 Oil field water supply 9 Dewatering 12 Other (Specify below) 2 Irrigation 4 Industrial 7 Domestic (lawn & garden) 10 Monitoring well						
Was a chemical/bacteriological sample submitted to Department? Yes No X...; If yes, mo/day/yr Sample was submitted Water well disinfected? Yes X... No						
5 TYPE OF CASING USED: 1 Steel 3 RMP (SR) 2 PVC 4 ABS		5 Wrought Iron 6 Asbestos-Cement 7 Fiberglass	8 Concrete tile 9 Other (specify below)	CASING JOINTS: Glued... X... Clamped..... Welded..... Threaded.....		
Blank casing diameter 6 in. to 140 ft. Diameter in. to ft., Diameter in. to ft. Casing height above land surface 24 in., Weight 4.704 lbs./ft. Wall thickness or guage No. SDR. 21.316						
TYPE OF SCREEN OR PERFORATION MATERIAL: 1 Steel 3 Stainless Steel 5 Fiberglass 7 PVC 9 ABS 11 Other (Specify) 2 Brass 4 Galvanized Steel 6 Concrete tile 8 RM (SR) 10 Asbestos-Cement 12 None used (open hole)						
SCREEN OR PERFORATION OPENINGS ARE: 1 Continuous slot 3 Mill slot 5 Guazed wrapped 7 Torch cut 9 Drilled holes 11 None (open hole) 2 Louvered shutter 4 Key punched 6 Wire wrapped 8 Saw Cut 10 Other (specify)						
SCREEN-PERFORATED INTERVALS: From 140 ft. to 180 ft., From ft. to ft. to ft. From ft. to ft., From ft. to ft. to ft.						
GRAVEL PACK INTERVALS: From 50 ft. to 180 ft., From ft. to ft. to ft. From ft. to ft., From ft. to ft. to ft.						
6 GROUT MATERIAL: 1 Neat cement 2 Cement grout 3 Bentonite 4 Other hole plug..... Grout Intervals: From 1 ft. to 25 ft., From ft. to ft., From ft. to ft. What is the nearest source of possible contamination: 1 Septic tank 4 Lateral lines 7 Pit privy 10 Livestock pens 13 Insecticide Storage 16 Other (specify) 2 Sewer lines 5 Cess pool 8 Sewage lagoon 11 Fuel storage 14 Abandoned water well below) 3 Watertight sewer lines 6 Seepage pit 9 Feedyard 12 Fertilizer Storage 15 Oil well/gas well						
Direction from well? South east How many feet? 250						
FROM	TO	LITHOLOGIC LOG		FROM	TO	PLUGGING INTERVALS
0	2	Surface				
2	35	Clay				
35	88	Sand and gravel				
88	99	Sandy clay and clay				
99	118	Sand				
118	122	Clay				
122	128	Sand				
128	140	Sandstone and sand and clay streaks				
140	175	Sand				
175	180	Clay "green"				
7 CONTRACTOR'S OR LANDOWNER'S CERTIFICATION: This water well was (1) constructed, (2) reconstructed, or (3) plugged under my jurisdiction and was completed on (mo/day/year) 01-13-08 and this record is true to the best of my knowledge and belief. Kansas Water Well Contractor's License No. KWWCL430 . This Water Well Record was completed on (mo/day/year) 01-13-08 under the business name of Howard Drilling Box 806 Beaver, Ok (signature) 						
INSTRUCTIONS: Use typewriter or ball point pen. PLEASE PRESS FIRMLY and PRINT clearly. Please fill in blanks, and check or circle the correct answers. Send top three copies to Kansas Department of Health and Environment, Bureau of Water, Geology Section, 1000 SW Jackson St., Suite 420, Topeka, Kansas 66612-1367. Telephone 785-296-5522. Send one to WATER WELL OWNER and retain one for your records. Fee of \$5.00 for each <u>constructed</u> well. Visit us at http://www.kdhe.state.ks.us/geo/waterwells .						