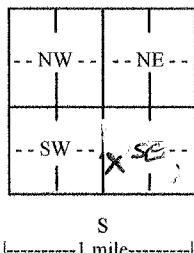
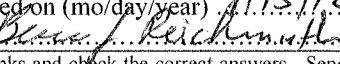


WATER WELL RECORD

Form WWC-5

Division of Water Resources App. No.

4887 & 10639

1 LOCATION OF WATER WELL: County: Gray		Fraction 1/4 NW 1/4 SW 1/4 SE 1/4	Section Number 24	Township No. T 24 S	Range Number R 29 <input type="checkbox"/> E <input checked="" type="checkbox"/> W																				
Street/Rural Address of Well Location; if unknown, distance & direction from nearest town or intersection: If at owner's address, check here <input type="checkbox"/> . Approx. 9 miles North of Ingalls Kansas																									
2 WATER WELL OWNER: RR#, Street Address, Box #: 05013 13 RD City, State, ZIP Code : Ingalls, Ks 67853		Global Positioning System (GPS) information: Latitude: 37.94584 N (in decimal degrees) Longitude: 100.45521 W (in decimal degrees) Elevation: Datum: <input type="checkbox"/> WGS 84, <input type="checkbox"/> NAD 83, <input checked="" type="checkbox"/> NAD 27 Collection Method: <input checked="" type="checkbox"/> GPS unit (Make/Model:) <input type="checkbox"/> Digital Map/Photo, <input type="checkbox"/> Topographic Map, <input type="checkbox"/> Land Survey Est. Accuracy: <input type="checkbox"/> <3 m, <input type="checkbox"/> 3-5 m, <input type="checkbox"/> 5-15 m, <input type="checkbox"/> >15 m																							
3 LOCATE WELL WITH AN "X" IN SECTION BOX: N 		4 DEPTH OF COMPLETED WELL 240 ft. Depth(s) Groundwater Encountered (1) ft. (2) ft. (3) ft. WELL'S STATIC WATER LEVEL 150 ft. below land surface measured on mo/day/yr. 12-27-11 Pump test data: Well water was 202 ft. after 2 hours pumping 135 gpm EST. YIELD gpm. Well water was ft. after hours pumping gpm Bore Hole Diameter 17 1/2 in. to 240 ft., and in. to ft. WELL WATER TO BE USED AS: <input type="checkbox"/> Public water supply <input type="checkbox"/> Geothermal <input type="checkbox"/> Injection well <input type="checkbox"/> Domestic <input checked="" type="checkbox"/> Feedlot <input type="checkbox"/> Oil field water supply <input type="checkbox"/> Dewatering <input type="checkbox"/> Other (Specify below) <input type="checkbox"/> Irrigation <input type="checkbox"/> Industrial <input type="checkbox"/> Domestic-lawn & garden <input type="checkbox"/> Monitoring well Was a chemical/bacteriological sample submitted to Department? <input type="checkbox"/> Yes <input checked="" type="checkbox"/> No If yes, mo/day/yr sample was submitted Water well disinfected? <input checked="" type="checkbox"/> Yes <input type="checkbox"/> No																							
5 TYPE OF CASING USED: <input type="checkbox"/> Steel <input checked="" type="checkbox"/> PVC <input type="checkbox"/> Other CASING JOINTS: <input checked="" type="checkbox"/> Glued <input type="checkbox"/> Clamped <input type="checkbox"/> Welded <input type="checkbox"/> Threaded Casing diameter .8 in. to 240 ft., Diameter in. to ft., Diameter in. to ft. Casing height above land surface 12 in., Weight 6.99 lbs./ft., Wall thickness or gauge No. 410 TYPE OF SCREEN OR PERFORATION MATERIAL: <table style="width: 100%;"><tr><td><input type="checkbox"/> Steel</td><td><input type="checkbox"/> Stainless Steel</td><td><input checked="" type="checkbox"/> PVC</td><td><input type="checkbox"/> Other (Specify)</td></tr><tr><td><input type="checkbox"/> Brass</td><td><input type="checkbox"/> Galvanized Steel</td><td><input type="checkbox"/> None used (open hole)</td><td></td></tr></table> SCREEN OR PERFORATION OPENINGS ARE: <table style="width: 100%;"><tr><td><input type="checkbox"/> Continuous slot</td><td><input checked="" type="checkbox"/> Mill slot</td><td><input type="checkbox"/> Gauze wrapped</td><td><input type="checkbox"/> Torch cut</td><td><input type="checkbox"/> Drilled holes</td><td><input type="checkbox"/> None (open hole)</td></tr><tr><td><input type="checkbox"/> Louvered shutter</td><td><input type="checkbox"/> Key punched</td><td><input type="checkbox"/> Wire wrapped</td><td><input type="checkbox"/> Saw cut</td><td><input type="checkbox"/> Other (specify)</td><td></td></tr></table> SCREEN-PERFORATED INTERVALS: From 160 ft. to 220 ft., From ft. to ft. From ft. to ft., From ft. to ft. GRAVEL PACK INTERVALS: From 25 ft. to 240 ft., From ft. to ft. From ft. to ft., From ft. to ft.						
6 GROUT MATERIAL: <input type="checkbox"/> Neat cement <input type="checkbox"/> Cement grout <input checked="" type="checkbox"/> Bentonite <input type="checkbox"/> Other Grout Intervals: From 0 ft. to 20 ft., From ft. to ft., From ft. to ft. What is the nearest source of possible contamination: <table style="width: 100%;"><tr><td><input type="checkbox"/> Septic tank</td><td><input type="checkbox"/> Lateral lines</td><td><input type="checkbox"/> Pit privy</td><td><input type="checkbox"/> Livestock pens</td><td><input type="checkbox"/> Insecticide storage</td><td><input type="checkbox"/> Other (specify below)</td></tr><tr><td><input type="checkbox"/> Sewer lines</td><td><input type="checkbox"/> Cesspool</td><td><input type="checkbox"/> Sewage lagoon</td><td><input type="checkbox"/> Fuel storage</td><td><input checked="" type="checkbox"/> Abandoned water well</td><td></td></tr><tr><td><input type="checkbox"/> Watertight sewer lines</td><td><input type="checkbox"/> Seepage pit</td><td><input type="checkbox"/> Feedyard</td><td><input type="checkbox"/> Fertilizer storage</td><td><input type="checkbox"/> Oil well/gas well</td><td></td></tr></table> Direction from well North Distance from well 230'						<input type="checkbox"/> Septic tank	<input type="checkbox"/> Lateral lines	<input type="checkbox"/> Pit privy	<input type="checkbox"/> Livestock pens	<input type="checkbox"/> Insecticide storage	<input type="checkbox"/> Other (specify below)	<input type="checkbox"/> Sewer lines	<input type="checkbox"/> Cesspool	<input 
FROM	TO	LITHOLOGIC LOG	FROM	TO	LITHO. LOG (cont.) or PLUGGING INTERVALS																				
0	2	SURFACE	188	197	SAND FINE																				
2	40	BROWN CLAY CALICHE	197	205	BROWN CLAY																				
40	56	WHITE GREY CLAY , CALICHE	205	220	SAND FINE TO SMALL FEW CLAY																				
56	79	SAND, FINE MED COURSE, FEW LEDG	220	256	BROWN CLAY FEW SAND																				
79	90	SAND FINE	256	261	YELLOW CLAY																				
90	110	BROWN CLAY FINE SAND	261	280	SHALE																				
110	140	SAND FINE TO MED																							
140	155	BROWN CLAY FEW LIMEROCK																							
155	173	SAND FINE TO MED COURSE SM GRV																							
173	188	BROWN CLAY FEW LIMEROCK																							
7 CONTRACTOR'S OR LANDOWNER'S CERTIFICATION: This water well was <input checked="" type="checkbox"/> constructed, <input type="checkbox"/> reconstructed, or <input type="checkbox"/> plugged under my jurisdiction and was completed on (mo/day/year) and this record is true to the best of my knowledge and belief. Kansas Water Well Contractor's License No. 145 This Water Well Record was completed on (mo/day/year) 11-15-12 under the business name of HYDRO RESOURCES by (signature) 																									
INSTRUCTIONS: Use typewriter or ball point pen. <u>PLEASE PRESS FIRMLY</u> and <u>PRINT</u> clearly. Please fill in blanks and check the correct answers. Send three copies (white, blue, pink) to Kansas Department of Health and Environment, Bureau of Water, Geology Section, 1000 SW Jackson St., Suite 420, Topeka, Kansas 66612-1367. Telephone 785-296-5522. Send one copy to WATER WELL OWNER and retain one for your records. Include <u>fee</u> of \$5.00 for each <u>constructed</u> well. Visit us at http://www.kdheks.gov/waterwell/index.html .																									