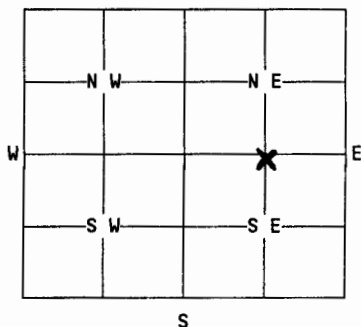


1 LOCATION OF WATER WELL:	Fraction NC-NORTH SIDE 1/4 1/4 SE 1/4	Section Number 27	Township Number 24 SOUTH	Range Number DE 9 1996
---------------------------	---	----------------------	-----------------------------	---------------------------

Distance and direction from nearest town or city street address of well if located within city?

FROM PATTERSON, KS: 3/4 MILE SOUTH AND 3/4 MILE EAST

2 WATER WELL OWNER: COMANCHE WEST, INC. C/O FRED SOPER, PRESIDENT

RR#, St. Address, Box #: 310 W. CENTRAL, SUITE 201
City, State, ZIP Code : WICHITA, KS 67204Board of Agriculture, Division of Water Resources
Application Number: 317753 MARK WELL'S LOCATION WITH
AN "X" IN SECTION BOX:
N

4 DEPTH OF WELL 51.5 ft.

WELL'S STATIC WATER LEVEL 12.4 ft.

WELL WAS USED AS:

- | | | |
|--------------|--------------------------|--------------------|
| 1 Domestic | 5 Public Water Supply | 9 Dewatering |
| 2 Irrigation | 6 Oil Field Water Supply | 10 Monitoring Well |
| 3 Feedlot | 7 Lawn and Garden Only | 11 Injection Well |
| 4 Industrial | 8 Air Conditioning | 12 Other..... |

Was a chemical/bacteriological sample submitted to Department? Yes....No.X..
If yes, mo/day/yr sample was submitted.....

Water Well Disinfected: Yes...X.. No.....

5 TYPE OF BLANK CASING USED:

- | | | | | |
|---------|------------|-------------------|-----------------|-------------------------|
| 1 Steel | 3 RMP (SR) | 5 Wrought | 7 Fiberglass | 9 Other (specify below) |
| 2 PVC | 4 ABS | 6 Asbestos-Cement | 8 Concrete Tile | |

Blank casing diameter 16 in. Was casing pulled? Yes..... No.X.... If yes, how much.....
Casing height above or below land surface 40 in.

6 GROUT PLUG MATERIAL: 1 Neat cement 2 Cement grout 3 Bentonite 4 Other.....

Grout Plug Intervals: From 12 ft. to 4 ft., From 4 ft. to 3.5 ft., From..... to.....ft.

What is the nearest source of possible contamination:

- | | | | |
|--------------------------|-------------------|-------------------------|--------------------------|
| 1 Septic tank | 6 Seepage pit | 11 Fuel storage | 16 Other (specify below) |
| 2 Sewer lines | 7 Pit privy | 12 Fertilizer storage | |
| 3 Watertight sewer lines | 8 Sewage lagoon | 13 Insecticide storage | |
| 4 Lateral lines | 9 Feedyard | 14 Abandoned water well | NONE WITHIN |
| 5 Cess Pool | 10 Livestock pens | 15 Oil well/Gas well | 1/2 MILE |

Direction from well?

How many feet?

FROM	TO	PLUGGING MATERIALS
51.5	12	CLEAN, COARSE SAND
12	4	CEMENT GROUT
4	3.5	BENTONITE HOLEPLUG CHIPS
3.5	0	TOPSOIL

*PLUGGING WITNESSED BY
TIM BOESE, EQUUS BEDS GMD2.7 CONTRACTOR'S OR LANDOWNER'S CERTIFICATION: This water well was plugged under my jurisdiction and was completed on (mo/day/year) 12-18-96 and this record is true to the best of my knowledge and belief. Kansas Water Well Contractor's License No. NA This Water Well Record was completed on (mo/day/year) 12-18-96 under the business name of NA
by (signature) Fred Soper, President

INSTRUCTIONS: Use typewriter or ball point pen. Please press firmly and print clearly. Please fill in blanks, underline or circle the correct answers. Send top three copies to Kansas Department of Health and Environment, Bureau of Water, Topeka, Kansas 66620-0001. Telephone: 913/296-3565. Send one to Water Well Owner and retain one for your records.