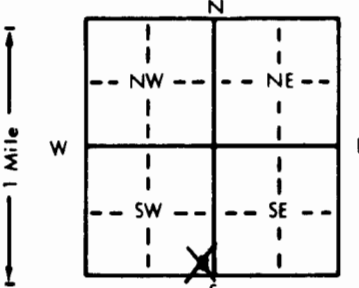


1 LOCATION OF WATER WELL: County: <u>Harvey</u>		Fraction <u>SE</u> $\frac{1}{4}$ <u>SE</u> $\frac{1}{4}$ <u>SW</u> $\frac{1}{4}$		Section Number <u>3</u>	Township Number <u>T 24 S</u>	Range Number <u>R 3 W</u>	
Distance and direction from nearest town or city street address of well if located within city? <u>1 1/2 miles East & 3 miles South of Burton, KS</u>	
2 WATER WELL OWNER: <u>Equus Beds GMD #2</u> RR#, St. Address, Box # : <u>313 Spruce</u> City, State, ZIP Code : <u>Halstead, KS 67056-1925</u> Board of Agriculture, Division of Water Resources Application Number:	
3 LOCATE WELL'S LOCATION WITH AN "X" IN SECTION BOX: 		4 DEPTH OF COMPLETED WELL: <u>235</u> ft. ELEVATION:ft. Depth(s) Groundwater Encountered 1. <u>14</u> ft. 2.ft. 3.ft. WELL'S STATIC WATER LEVEL <u>14</u> ft. below land surface measured on mo/day/yr <u>10-2-90</u> Pump test data: Well water wasft. after hours pumping gpm Est. Yield gpm: Well water wasft. after hours pumping gpm Bore Hole Diameter <u>6</u> in. to <u>240</u> ft., andin. toft. WELL WATER TO BE USED AS: 5 Public water supply 8 Air conditioning 11 Injection well 1 Domestic 3 Feedlot 6 Oil field water supply 9 Dewatering 12 Other (Specify below) 2 Irrigation 4 Industrial 7 Lawn and garden only 10 Monitoring well Was a chemical/bacteriological sample submitted to Department? Yes.....No <u>X</u>; If yes, mo/day/yr sample was submitted Water Well Disinfected? Yes No <u>X</u>	
5 TYPE OF BLANK CASING USED: 1 Steel 3 RMP (SR) 5 Wrought iron 8 Concrete tile CASING JOINTS: Glued <u>X</u> Clamped 2 PVC 4 ABS 6 Asbestos-Cement 9 Other (specify below) Welded 7 Fiberglass Threaded..... Blank casing diameter <u>2"</u> Steel in. to <u>7</u> ft., Dia <u>2"</u> PVC in. to <u>225</u> ft., Diain. toft. Casing height above land surface <u>36</u> in., weight <u>1.703</u> lbs./ft. Wall thickness or gauge No. <u>154</u> TYPE OF SCREEN OR PERFORATION MATERIAL: 7 PVC 10 Asbestos-cement 1 Steel 3 Stainless steel 5 Fiberglass 8 RMP (SR) 11 Other (specify) 2 Brass 4 Galvanized steel 6 Concrete tile 9 ABS 12 None used (open hole) SCREEN OR PERFORATION OPENINGS ARE: 5 Gauzed wrapped 8 Saw cut 11 None (open hole) 1 Continuous slot 3 Mill slot 6 Wire wrapped 9 Drilled holes 2 Louvered shutter 4 Key punched 7 Torch cut 10 Other (specify) SCREEN-PERFORATED INTERVALS: From <u>225</u> ft. to <u>235</u> ft., Fromft. toft. Fromft. toft., Fromft. toft. GRAVEL PACK INTERVALS: From <u>215</u> ft. to <u>235</u> ft., Fromft. toft. Fromft. toft., Fromft. toft.	
6 GROUT MATERIAL: 1 Neat cement 2 Cement grout 3 Bentonite 4 Other Grout Intervals: From <u>0</u> ft. to <u>215</u> ft., Fromft. toft., Fromft. toft. What is the nearest source of possible contamination: 10 Livestock pens 14 Abandoned water well 1 Septic tank 4 Lateral lines 7 Pit privy 11 Fuel storage 15 Oil well/Gas well 2 Sewer lines 5 Cess pool 8 Sewage lagoon 12 Fertilizer storage 16 Other (specify below) 3 Watertight sewer lines 6 Seepage pit 9 Feedyard 13 Insecticide storage Direction from well? <u>East</u> How many feet? <u>200ft</u>	
<table border="1" style="width:100%; border-collapse: collapse;"><thead><tr><th>FROM</th><th>TO</th><th>LITHOLOGIC LOG</th><th>FROM</th><th>TO</th><th>PLUGGING INTERVALS</th></tr></thead><tbody><tr><td>0</td><td>8</td><td>Top Soil</td><td></td><td></td><td></td></tr><tr><td>8</td><td>29</td><td>Medium Course Sand & Gravel</td><td></td><td></td><td></td></tr><tr><td>29</td><td>33</td><td>Tan Clay</td><td></td><td></td><td></td></tr><tr><td>33</td><td>58</td><td>Medium Course Sand & Gravel</td><td></td><td></td><td></td></tr><tr><td>58</td><td>60</td><td>Green Clay</td><td></td><td></td><td></td></tr><tr><td>60</td><td>93</td><td>Medium Course Sand & Gravel</td><td></td><td></td><td></td></tr><tr><td>93</td><td>106</td><td>Green Clay</td><td></td><td></td><td></td></tr><tr><td>106</td><td>134</td><td>Gray Clay</td><td></td><td></td><td></td></tr><tr><td>134</td><td>161</td><td>Fine Sand</td><td></td><td></td><td></td></tr><tr><td>161</td><td>162</td><td>Tan Clay</td><td></td><td></td><td></td></tr><tr><td>162</td><td>181</td><td>Fine Sand</td><td></td><td></td><td></td></tr><tr><td>181</td><td>215</td><td>Brown Clay</td><td></td><td></td><td></td></tr><tr><td>215</td><td>235</td><td>Fine Sand</td><td></td><td></td><td></td></tr><tr><td>235</td><td>240</td><td>Gray Shale</td><td></td><td></td><td></td></tr>
7 CONTRACTOR'S OR LANDOWNER'S CERTIFICATION: This water well was (1) constructed, (2) reconstructed, or (3) plugged under my jurisdiction and was completed on (mo/day/year) <u>10-2-90</u> and this record is true to the best of my knowledge and belief. Kansas Water Well Contractor's License No. <u>138</u> This Water Well Record was completed on (mo/day/yr) <u>11-27-90</u> under the business name of <u>Peterson Irrigation, Inc.</u> by (signature) <u>Mike Peterson</u>	