

CORRECTION(S) TO WATER WELL RECORD (WWC-5)

(to rectify lacking or incorrect information)

Location listed as:

Section-Township-Range: 3-24 S-3 W

Fraction ($\frac{1}{4}$ $\frac{1}{4}$ $\frac{1}{4}$): SW SW SE

County: Harvey

Location changed to:

3-24 S-3 W

SE SE SW

Other changes: Initial statements: _____

Changed to: _____

Comments: _____

verification method: Other records for this well, and mapping
tool on KGS website.

initials: DRJ date: 10/4/2006

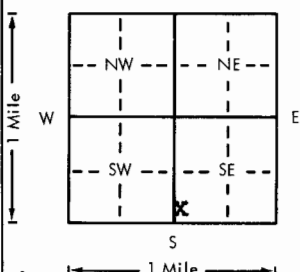
submitted by: Kansas Geological Survey, Data Resources Library, 1930 Constant Ave., Lawrence, KS 66047-3726

to: Kansas Dept of Health & Environment, Bureau of Water, 1000 SW Jackson, Suite 420, Topeka, KS 66612-1367.

USE TYPEWRITER OR BALL
POINT PEN-PRESS FIRMLY,
PRINT CLEARLY.

WATER WELL RECORD
KSA 82a-1201-1215

Kansas Department of Health and
Environment-Division of Environment
(Water well Contractors)
Topeka, Kansas 66620

1. Location of well:		County Harvey	Fraction SW 1/4 SW 1/4 SE 1/4	Section number 3	Township number T 24 S R 3 E/W	Range number 3
2. Distance and direction from nearest town or city: 3 miles southeast of Burrton Street address of well location if in city:				3. Owner of well: Equus Beds GMD R.R. or street: Box 232 City, state, zip code: Halstead, Ks. 67056		
4. Locate with "X" in section below:		Sketch map:		6. Bore hole dia. 4 in. Completion date 6/78 Well depth 88 ft.		
				7. ☒ Cable tool ☒ Rotary ☐ Driven ☐ Dug ☐ Hollow rod ☐ Jetted ☐ Bored ☐ Reverse rotary		
Type and color of material		From		To		8. Use: ☐ Domestic ☐ Public supply ☐ Industry ☐ Irrigation ☐ Air conditioning ☐ Stock ☐ Lawn ☐ Oil field water ☒ Other
Log not available						9. Casing: Material ☐ Threaded ☐ Welded ☐ Surface 1.95 ft. in. RMP ☐ PVC ☒ Weight ☐ lbs./ft. Dia. 8 in. to 85 ft. depth Wall Thickness: inches or Dia. ☐ in. to ☐ ft. depth gage No. Sch 40
						10. Screen: Manufacturer's name Johnson Type wallpoint ☒ 1.25 in. Slot/gauze 10 Length 36 in. Set between 85 ft. and 88 ft. Gravel pack? no Size range of material
						11. Static water level: 10.59 ft. below land surface Date 8/28/78 mo./day/yr.
						12. Pumping level below land surfaces: ft. after hrs. pumping g.p.m. ft. after hrs. pumping g.p.m. Estimated maximum yield g.p.m.
						13. Water sample submitted: mo./day/yr. Yes ☒ No ☐ Date
						14. Well head completion: Pitless adapter inches above grade
						☒ Well grouted? yes With: ☐ Neat cement ☐ Bentonite ☒ Concrete Depth: From 0 ft. to 2 ft.
						16. Nearest source of possible contamination: ft. Direction Type Well disinfected upon completion? Yes ☒ No ☐
						17. Pump: ☒ Not installed Manufacturer's name Model number HP Volts Length of drop pipe ft. capacity g.p.m. Type: ☐ Submersible ☐ Turbine ☐ Jet ☐ Reciprocating ☐ Centrifugal ☐ Other
18. Elevation: 1430 ft.		19. Remarks: EB - 13B		20. Water well contractor's certification: This well was drilled under my jurisdiction and this report is true to the best of my knowledge and belief. Equus Beds GMD Business name License No. Address Box 232, Halstead, Ks Signed Thomas C. Sell Date 1/16/79 Authorized representative		