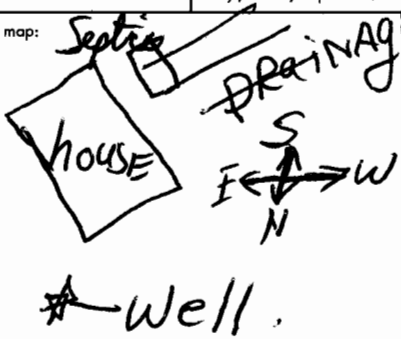


USE TYPEWRITER OR BALL
POINT PEN-PRESS FIRMLY,
PRINT CLEARLY.

WATER WELL RECORD
KSA 82a-1201-1215

Kansas Department of Health and
Environment-Division of Environment
(Water well Contractors)
Topeka, Kansas 66620

1. Location of well:		County: <u>HARVEY</u>	Fraction: <u>SE 1/4 SE 1/4 SW 1/4</u>	Section number: <u>7</u>	Township number: <u>T 24 S</u>	Range number: <u>R 3 E</u>
2. Distance and direction from nearest town or city: Street address of well location if in city:		3. Owner of well: <u>Lynn Baumann</u> R.R. or street: <u>R #1</u> City, state, zip code: <u>Buckerton KS 67020</u>				
4. Locate with "X" in section below: N W E S 1 Mile 1 Mile		Sketch map: 		6. Bore hole dia. <u>3 1/2</u> in. Completion date: <u>9/27/77</u> Well depth <u>37</u> ft.		
5. Type and color of material		From		To		7. ☒ Cable tool ☒ Rotary ☐ Driven ☐ Dug ☐ Hollow rod ☐ Jetted ☐ Bored ☐ Reverse rotary
<u>top soil</u>		<u>0</u>		<u>6</u>		8. Use: ☒ Domestic ☐ Public supply ☐ Industry ☐ Irrigation ☐ Air conditioning ☐ Stock ☐ Lawn ☐ Oil field water ☐ Other
<u>fine sand</u>		<u>6</u>		<u>18</u>		9. Casing: Material <u>PVC</u> Height: <u>0</u> Above or below Threaded ☐ Welded ☒ Surface ☐ RMP ☐ PVC ☒ Weight <u>2.31</u> lbs./ft. Dia. <u>5</u> in. to <u>37</u> ft. depth Wall Thickness <u>1/4</u> inch or Dia. <u>5</u> in. to <u>37</u> ft. depth gage No. <u>1214</u>
<u>greenish clay</u>		<u>18</u>		<u>19</u>		10. Screen: Manufacturer's name <u>MPJ</u> Type <u>PVC</u> Dia. <u>5 1/2</u> Slot gauge <u>1/16</u> Length <u>5 1/2</u> Set between <u>32</u> ft. and <u>37</u> ft. ft. and <u>37</u> ft. Gravel pack? <u>yes</u> Size range of material <u>3/8</u>
<u>fine to coarse gravel</u>		<u>19</u>		<u>36</u>		11. Static water level: <u>10</u> ft. below land surface Date <u>9/27/77</u> mo./day/yr.
<u>greenish clay</u>		<u>36</u>		<u>37</u>		12. Pumping level below land surfaces: <u>12</u> ft. after <u>15</u> hrs. pumping <u>20</u> g.p.m. ft. after <u>15</u> hrs. pumping <u>20</u> g.p.m. Estimated maximum yield <u>50</u> g.p.m.
						13. Water sample submitted: <u>Yes</u> ☒ No ☐ Date <u>9/27/77</u> mo./day/yr.
						14. Well head completion: Pitless adapter <u>12</u> inches above grade
						15. Well grouted? ☒ With: <u>Neat cement</u> ☐ Bentonite ☐ Concrete ☐ Depth: From <u>12</u> ft. to <u>37</u> ft.
						16. Nearest source of possible contamination: ft. <u>150</u> Direction <u>west</u> Type <u>Synthetic</u> Well disinfected upon completion? ☒ Yes ☐ No
						17. Pump: ☒ Not installed Manufacturer's name <u>Wenger</u> Model number <u>1/2</u> HP <u>1/2</u> Volts <u>115</u> Length of drop pipe <u>37</u> ft. capacity <u>20</u> g.p.m. Type: ☐ Submersible ☐ Turbine ☐ Jet ☐ Reciprocating ☐ Centrifugal ☐ Other
18. Elevation:		19. Remarks:		20. Water well contractor's certification: This well was drilled under my jurisdiction and this report is true to the best of my knowledge and belief. Business name <u>Wenger Drilling</u> 3/18 Address <u>1/2 R 1/4 Sec 31</u> Signed <u>James Wenger</u> Date <u>9/27/77</u> Authorized representative		
Topography: ☐ Hill ☐ Slope ☒ Upland ☐ Valley						