


1 LOCATION OF WATER WELL: County: HARVEY	Fraction NE 1/4 SW 1/4 SE 1/4	Section Number 9	Township Number T 24 S	Range Number R 3W E 1
--	---	----------------------------	----------------------------------	---------------------------------

Distance and direction from nearest town or city street address of well if located within city?

4 mi. S + .75 E of BURTON

2 WATER WELL OWNER: RR#, St. Address, Box # : City, State, ZIP Code :	REGIER INC. RT. 3, Box 67 BURTON, KS. 67020	Board of Agriculture, Division of Water Resources Application Number:
---	--	--

3 LOCATE WELL'S LOCATION WITH AN "X" IN SECTION BOX:	4 DEPTH OF COMPLETED WELL NA ft. ELEVATION: 10.5 ft.
--	--

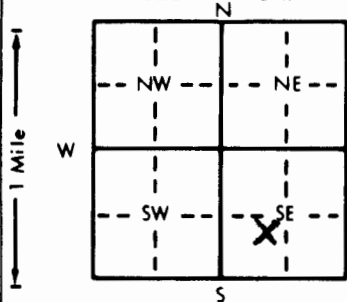

Depth(s) Groundwater Encountered 10.5 ft.	2. 10.5 ft.	3. 15 JAN 92 ft.
WELL'S STATIC WATER LEVEL 10.5 ft. below land surface measured on mo/day/yr	15 JAN 92	
Pump test data: Well water was	ft. after	hours pumping
Est. Yield	gpm	Well water was
Bore Hole Diameter	in. to	ft., and
WELL WATER TO BE USED AS:	5 Public water supply	8 Air conditioning
1 Domestic	3 Feedlot	6 Oil field water supply
2 Irrigation	4 Industrial	7 Lawn and garden only
10 Monitoring well	RECREATION	
Was a chemical/bacteriological sample submitted to Department? Yes	No X	If yes, mo/day/yr sample was submitted
Water Well Disinfected? Yes X	No	

5 TYPE OF BLANK CASING USED:	5 Wrought iron	8 Concrete tile	CASING JOINTS: Glued	Clamped
1 Steel	3 RMP (SR)	6 Asbestos-Cement	9 Other (specify below)	Welded
2 PVC	4 ABS	7 Fiberglass		Threaded
Blank casing diameter 6 in. to	ft., Dia	in. to	ft., Dia	in. to
Casing height above land surface 3 FT. BELOW X	weight	lbs./ft.	Wall thickness or gauge No.	
TYPE OF SCREEN OR PERFORATION MATERIAL:	7 PVC	10 Asbestos-cement		
1 Steel	3 Stainless steel	5 Fiberglass	8 RMP (SR)	11 Other (specify) N/A
2 Brass	4 Galvanized steel	6 Concrete tile	9 ABS	12 None used (open hole)
SCREEN OR PERFORATION OPENINGS ARE:	5 Gauzed wrapped	8 Saw cut	11 None (open hole)	
1 Continuous slot	3 Mill slot	6 Wire wrapped	9 Drilled holes	
2 Louvered shutter	4 Key punched	7 Torch cut	10 Other (specify) N/A	
SCREEN-PERFORATED INTERVALS:	From N/A ft. to N/A ft.	From N/A ft. to N/A ft.		
GRAVEL PACK INTERVALS:	From N/A ft. to N/A ft.	From N/A ft. to N/A ft.		

6 GROUT MATERIAL:	1 Neat cement	2 Cement grout	3 Bentonite	4 Other
Grout Intervals: From 6 ft. to 3 ft.	From 3 ft. to 0 ft.	From 0 ft. to 0 ft.	From 0 ft. to 0 ft.	From 0 ft. to 0 ft.
What is the nearest source of possible contamination:	1 Septic tank	4 Lateral lines	7 Pit privy	10 Livestock pens
2 Sewer lines	5 Cess pool	8 Sewage lagoon	11 Fuel storage	14 Abandoned water well
3 Watertight sewer lines	6 Seepage pit	9 Feedyard	12 Fertilizer storage	15 Oil well/Gas well
			13 Insecticide storage	16 Other (specify below) NONE

Direction from well?	FROM	TO	LITHOLOGIC LOG	FROM	TO	PLUGGING INTERVALS
	BOTTOM	11'	SAND & GRAVEL			
	11'	6'	CLAYS			
	6'	3'	CEMENT GROUT			
	3'	0	SOILS & CLAYS			

7 CONTRACTOR'S OR LANDOWNER'S CERTIFICATION: This water well was (1) constructed, (2) reconstructed, or (3) plugged under my jurisdiction and was completed on (mo/day/year) 5 MAR 92 and this record is true to the best of my knowledge and belief. Kansas Water Well Contractor's License No. 9 MAR 92 This Water Well Record was completed on (mo/day/yr) 9 MAR 92 under the business name of Duane E. Regier by (signature) Duane E. Regier
