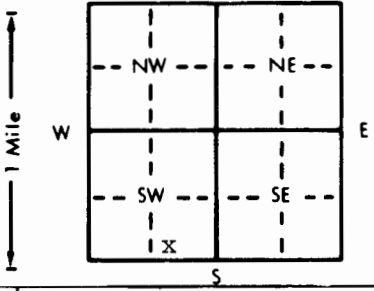


1 LOCATION OF WATER WELL:		Fraction	Section Number	Township Number	Range Number
County: Harvey		SW 1/4 SE 1/4 SW 1/4	11	T 24 S	R 3 EW
Distance and direction from nearest town or city street address of well if located within city? Approximately 2 miles north and 1 1/2 miles east of Patterson					
2 WATER WELL OWNER:		Wichita, City of 12th Floor City Building RR#, St. Address, Box #: 455 N. Main City, State, ZIP Code: Wichita, KS 67202			
		Board of Agriculture, Division of Water Resources Application Number: 1006			
3 LOCATE WELL'S LOCATION WITH AN "X" IN SECTION BOX:		4 DEPTH OF COMPLETED WELL: 51 ft. ELEVATION:			
		Depth(s) Groundwater Encountered 1. ft. 2. ft. 3. ft. WELL'S STATIC WATER LEVEL 26. ft. below land surface measured on mo/day/yr Pump test data: Well water was ft. after hours pumping gpm Est. Yield gpm: Well water was ft. after hours pumping gpm Bore Hole Diameter in. to ft., and in. to ft. WELL WATER TO BE USED AS: 5 Public water supply 8 Air conditioning 11 Injection well 1 Domestic 3 Feedlot 6 Oil field water supply 9 Dewatering 12 Other (Specify below) 2 Irrigation 4 Industrial 7 Lawn and garden only 10 Monitoring well Was a chemical/bacteriological sample submitted to Department? Yes.....No.....; If yes, mo/day/yr sample was submitted Water Well Disinfected? Yes No			
5 TYPE OF BLANK CASING USED:		CASING JOINTS: Glued Clamped Welded Threaded			
1 Steel 3 RMP (SR) 2 PVC 4 ABS		5 Wrought iron 6 Asbestos-Cement 7 Fiberglass			
Blank casing diameter 18. in. to ft., Dia. in. to ft., Dia. in. to ft.		8 Concrete tile 9 Other (specify below)			
Casing height above land surface 0 feet below XX, weight lbs./ft. Wall thickness or gauge No.		10 Asbestos-cement 11 Other (specify) 12 None used (open hole)			
TYPE OF SCREEN OR PERFORATION MATERIAL:		7 PVC 8 RMP (SR) 9 ABS			
1 Steel 3 Stainless steel 5 Fiberglass 6 Concrete tile		10 Asbestos-cement 11 Other (specify) 12 None used (open hole)			
2 Brass 4 Galvanized steel		7 PVC 8 RMP (SR) 9 ABS			
SCREEN OR PERFORATION OPENINGS ARE:		5 Gauzed wrapped 6 Wire wrapped 7 Torch cut			
1 Continuous slot 3 Mill slot 4 Key punched		8 Saw cut 9 Drilled holes 10 Other (specify) 11 None (open hole)			
SCREEN-PERFORATED INTERVALS: From ft. to ft., From ft. to ft.		12 None used (open hole)			
GRAVEL PACK INTERVALS: From ft. to ft., From ft. to ft.		13 Insecticide storage none known			
6 GROUT MATERIAL: 1 Neat cement 2 Cement grout 3 Bentonite 4 Other		14 Abandoned water well 15 Oil well/Gas well 16 Other (specify below)			
Direction from well?		How many feet?			
FROM	TO	LITHOLOGIC LOG	FROM	TO	PLUGGING INTERVALS
			51	27	Chlorinated sand
			27	0	Cement Grout
7 CONTRACTOR'S OR LANDOWNER'S CERTIFICATION: This water well was (1) constructed, (2) reconstructed, or (3) plugged under my jurisdiction and was completed on (mo/day/year) 8-2-91 and this record is true to the best of my knowledge and belief. Kansas Water Well Contractor's License No. 185. This Water Well Record was completed on (mo/day/yr) 8-16-91 under the business name of Clarke Well & Equipment, Inc. by (signature) [Signature]					