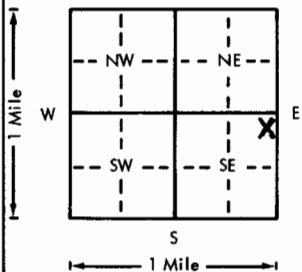


USE TYPEWRITER OR BALL
POINT PEN-PRESS FIRMLY,
PRINT CLEARLY.

WATER WELL RECORD
KSA 82a-1201-1215

Kansas Department of Health and
Environment-Division of Environment
(Water well Contractors)
Topeka, Kansas 66620

1. Location of well: County <u>Harvey</u> Fraction <u>NE 1/4 NE 1/4 SE 1/4</u> Section number <u>13</u> Township number <u>T 24</u> Range number <u>S 3 R 3 E W</u>	
2. Distance and direction from nearest town or city: <u>4 W, 2 1/2 S.</u> 3. Owner of well: <u>Gary Keck</u> Street address of well location if in city: <u>4414 N. 1st St.</u> R.R. or street: <u>Route 2</u> City, state, zip code: <u>Halsstead, Kans.</u>	
4. Locate with "X" in section below: Sketch map: 	
5. Type and color of material	
6. Bore hole dia. <u>11</u> in. Completion date <u>3-26-76</u> Well depth <u>80</u> ft.	
7. ☒ Cable tool ☒ Rotary ☐ Driven ☐ Dug ☐ Hollow rod ☐ Jetted ☐ Bored ☐ Reverse rotary	
8. Use: ☒ Domestic ☐ Public supply ☐ Industry ☐ Irrigation ☐ Air conditioning ☐ Stock ☐ Lawn ☐ Oil field water ☐ Other	
9. Casing: Material <u>Steel</u> Height Above or below Threaded ☐ Welded ☒ Surface <u>12</u> in. RMP ☒ PVC ☐ Weight <u>12</u> lbs./ft. Dia. <u>5</u> in. to <u>80</u> ft. depth Wall Thickness: inches or Dia. <u>5</u> in. to <u>80</u> ft. depth gage No. <u>200</u>	
10. Screen: Manufacturer's name <u>Sunflower Plastic</u> Type <u>Slotted</u> Dia. <u>5"</u> Slot/auge <u>1.00</u> Length <u>20'</u> Set between <u>50</u> ft. and <u>70</u> ft. Gravel pack? <u>yes</u> ft. and <u>14-1/2"</u> Size range of material	
11. Static water level: <u>18</u> ft. below land surface Date <u>3-26-76</u> mo./day/yr.	
12. Pumping level below land surfaces: ____ ft. after ____ hrs. pumping ____ g.p.m. ____ ft. after ____ hrs. pumping ____ g.p.m. Estimated maximum yield ____ g.p.m.	
13. Water sample submitted: ____ mo./day/yr. Yes ____ No ____ Date ____	
14. Well head completion: <u>12</u> capped ____ Pitless adapter ____ Inches above grade	
15. Well grouted? <u>yes</u> With: ____ Neat cement ____ Bentonite ☒ Concrete Depth: From <u>40'</u> to <u>14</u> ft.	
16. Nearest source of possible contamination: <u>Septic Tank</u> ft. <u>300</u> Direction <u>SW</u> Type <u>Septic Tank</u> Well disinfected upon completion? ☒ Yes ____ No	
17. Pump: ☒ Not installed Manufacturer's name ____ Model number ____ HP ____ Volts ____ Length of drop pipe ____ ft. capacity ____ g.p.m. Type: ____ Submersible ____ Turbine ____ Jet ____ Reciprocating ____ Centrifugal ____ Other	
18. Elevation: ____ Topography: ____ Hill ____ Slope ____ Upland ____ Valley	
19. Remarks: <u>Flat Ground.</u>	
20. Water well contractor's certification: This well was drilled under my jurisdiction and this report is true to the best of my knowledge and belief. <u>Shirley L. Lump</u> <u>236</u> Business name License No. Address <u>Wichita, Kans.</u> Signed <u>M. Arnold</u> Date <u>3-30-76</u> Authorized representative	