


1 LOCATION OF WATER WELL:	Fraction	SW	SW	Section Number	Township Number	Range Number
County: <u>Harvey</u>	<u>NE</u> $\frac{1}{4}$ <u>NE</u> $\frac{1}{4}$ <u>NE</u> $\frac{1}{4}$	<u>NE</u>	<u>NE</u>	<u>1715</u>	<u>T 2724</u>	<u>R 3</u> <u>E/W</u>

Distance and direction from nearest town or city street address of well if located within city?

1 mile North - Paterson, Kansas

2 WATER WELL OWNER:	RR#, St. Address, Box #	Board of Agriculture, Division of Water Resources
City, State, ZIP Code	Application Number:	

3 LOCATE WELL'S LOCATION WITH AN "X" IN SECTION BOX:	4 DEPTH OF COMPLETED WELL	ELEVATION:
--	---------------------------	------------

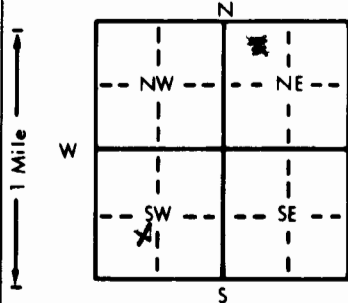

Depth(s) Groundwater Encountered 1. ft. 2. ft. 3. ft.

WELL'S STATIC WATER LEVEL ft. below land surface measured on mo/day/yr

Pump test data: Well water was ft. after hours pumping gpm

Est. Yield gpm: Well water was ft. after hours pumping gpm

Bore Hole Diameter in. to ft., and in. to ft.

WELL WATER TO BE USED AS:

1 Domestic 3 Feedlot 6 Oil field water supply 9 Dewatering 12 Other (Specify below)

2 Irrigation 4 Industrial 7 Lawn and garden only 10 Observation well

Was a chemical/bacteriological sample submitted to Department? Yes No; If yes, mo/day/yr sample was sub-

mitted

Water Well Disinfected? Yes No

5 TYPE OF BLANK CASING USED:	5 Wrought iron	8 Concrete tile	CASING JOINTS: Glued Clamped
------------------------------	----------------	-----------------	--

1 Steel 3 RMP (SR) 6 Asbestos-Cement 9 Other (specify below) Welded

2 PVC 4 ABS 7 Fiberglass Threaded

Blank casing diameter in. to ft., Dia in. to ft., Dia in. to ft.

Casing height above land surface in., weight lbs./ft. Wall thickness or gauge No.

TYPE OF SCREEN OR PERFORATION MATERIAL:

1 Steel 3 Stainless steel 5 Fiberglass 8 RMP (SR) 11 Other (specify)

2 Brass 4 Galvanized steel 6 Concrete tile 9 ABS 12 None used (open hole)

SCREEN OR PERFORATION OPENINGS ARE:

1 Continuous slot 3 Mill slot 5 Gauzed wrapped 8 Saw cut 11 None (open hole)

2 Louvered shutter 4 Key punched 6 Wire wrapped 9 Drilled holes

7 Torch cut 10 Other (specify)

SCREEN-PERFORATED INTERVALS: From ft. to ft., From ft. to ft.

From ft. to ft., From ft. to ft.

GRAVEL PACK INTERVALS: From ft. to ft., From ft. to ft.

From ft. to ft., From ft. to ft.

6 GROUT MATERIAL: 1 Neat cement 2 Cement grout 3 Bentonite 4 Other

Grout Intervals: From ft. to ft., From ft. to ft., From ft. to ft.

What is the nearest source of possible contamination:

1 Septic tank 4 Lateral lines 7 Pit privy 10 Livestock pens 14 Abandoned water well

2 Sewer lines 5 Cess pool 8 Sewage lagoon 11 Fuel storage 15 Oil well/Gas well

3 Watertight sewer lines 6 Seepage pit 9 Feedyard 12 Fertilizer storage 16 Other (specify below)

13 Insecticide storage

Direction from well? How many feet?

FROM TO LITHOLOGIC LOG FROM TO LITHOLOGIC LOG

110' 21' Filled casing w/ 3/8"

Bentonite chips (Hole Plug)

and cut casing off 2'

below ground level. Put

Hole plug to 1' above casing

1' below land surface.

Well # DR DeepOFFICE USE ONLY
T
R
E/W
SEC.