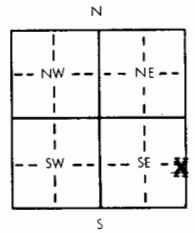


|   |  |                                              |                                                   |                            |                 |              |
|---|--|----------------------------------------------|---------------------------------------------------|----------------------------|-----------------|--------------|
| 1 LOCATION OF WATER WELL   |  | Fraction                                     | Section Number                                    |                            | Township Number | Range Number |
| County: <u>Harvey</u>   |  | NCO <u>1/4</u> E1/2 <u>1/4</u> SE <u>1/4</u> | 15                                                |                            | T 24 S          | R 3 E/W      |
| Distance and direction from nearest town or city?<br><u>1 mile north-1 mile east-1 mile north of Patterson</u>   |  |                                              | Street address of well if located within city?    |                            |                 |              |
| 2 WATER WELL OWNER: <u>Equus Beds Groundwater Management District #2</u>   |  |                                              |                                                   |                            |                 |              |
| RR#, St. Address, Box # : <u>243 Main</u>   |  |                                              | Board of Agriculture, Division of Water Resources |                            |                 |              |
| City, State, ZIP Code : <u>Halstead, Kansas 67056</u>   |  |                                              | Application Number:                               |                            |                 |              |
| 3 DEPTH OF COMPLETED WELL: <u>80</u> ft. Bore Hole Diameter: <u>4.0</u> in. to <u>85</u> ft., and in. to ft.   |  |                                              |                                                   |                            |                 |              |
| Well Water to be used as:   |  |                                              |                                                   |                            |                 |              |
| 1 Domestic 3 Feedlot 6 Oil field water supply 9 Dewatering 11 Injection well   |  |                                              |                                                   |                            |                 |              |
| 2 Irrigation 4 Industrial 7 Lawn and garden only 10 Observation well 12 Other (Specify below)   |  |                                              |                                                   |                            |                 |              |
| Well's static water level <u>14.83</u> ft. below land surface measured on <u>1</u> month <u>81</u> day <u>81</u> year   |  |                                              |                                                   |                            |                 |              |
| Pump Test Data : Well water was ft. after hours pumping gpm   |  |                                              |                                                   |                            |                 |              |
| Est. Yield gpm: Well water was ft. after hours pumping gpm   |  |                                              |                                                   |                            |                 |              |
| 4 TYPE OF BLANK CASING USED:   |  |                                              |                                                   |                            |                 |              |
| 1 Steel 3 RMP (SR) 6 Asbestos-Cement 9 Other (specify below) Welded   |  |                                              |                                                   |                            |                 |              |
| 2 PVC 4 ABS 7 Fiberglass Threaded   |  |                                              |                                                   |                            |                 |              |
| Blank casing dia <u>2.0</u> in. to <u>77</u> ft., Dia in. to ft., Dia in. to ft.   |  |                                              |                                                   |                            |                 |              |
| Casing height above land surface in., weight lbs./ft. Wall thickness or gauge No   |  |                                              |                                                   |                            |                 |              |
| TYPE OF SCREEN OR PERFORATION MATERIAL:   |  |                                              |                                                   |                            |                 |              |
| 1 Steel 3 Stainless steel 5 Fiberglass 8 RMP (SR) 10 Asbestos-cement Johnson Red-   |  |                                              |                                                   |                            |                 |              |
| 2 Brass 4 Galvanized steel 6 Concrete tile 9 ABS 11 Other (specify) head Wellpoint   |  |                                              |                                                   |                            |                 |              |
| 12 None used (open hole)   |  |                                              |                                                   |                            |                 |              |
| Screen or Perforation Openings Are:   |  |                                              |                                                   |                            |                 |              |
| 1 Continuous slot 3 Mill slot 5 Gauzed wrapped 8 Saw cut 11 None (open hole)   |  |                                              |                                                   |                            |                 |              |
| 2 Louvered shutter 4 Key punched 7 Torch cut 9 Drilled holes 10 Other (specify)   |  |                                              |                                                   |                            |                 |              |
| Screen-Perforation Dia <u>1.25</u> in. to ft., Dia in. to ft., Dia in. to ft.   |  |                                              |                                                   |                            |                 |              |
| Screen-Perforated Intervals: From <u>77</u> ft. to <u>80</u> ft., From ft. to ft., From ft. to ft.   |  |                                              |                                                   |                            |                 |              |
| Gravel Pack Intervals: From ft. to ft., From ft. to ft., From ft. to ft.   |  |                                              |                                                   |                            |                 |              |
| 5 GROUT MATERIAL: 1 Neat cement 2 Cement grout 3 Bentonite 4 Other   |  |                                              |                                                   |                            |                 |              |
| Grouted Intervals: From <u>0</u> ft. to <u>5</u> ft., From ft. to ft., From ft. to ft.   |  |                                              |                                                   |                            |                 |              |
| What is the nearest source of possible contamination:   |  |                                              |                                                   |                            |                 |              |
| 1 Septic tank 4 Cess pool 7 Sewage lagoon 10 Fuel storage 14 Abandoned water well   |  |                                              |                                                   |                            |                 |              |
| 2 Sewer lines 5 Seepage pit 8 Feed yard 11 Fertilizer storage 15 Oil well/Gas well   |  |                                              |                                                   |                            |                 |              |
| 3 Lateral lines 6 Pit privy 9 Livestock pens 12 Insecticide storage 16 Other (specify below)   |  |                                              |                                                   |                            |                 |              |
| 13 Watertight sewer lines   |  |                                              |                                                   |                            |                 |              |
| Direction from well How many feet ? Water Well Disinfected? Yes No <u>X</u>   |  |                                              |                                                   |                            |                 |              |
| Was a chemical/bacteriological sample submitted to Department? Yes No <u>X</u> If yes, date sample   |  |                                              |                                                   |                            |                 |              |
| was submitted month day year Pump Installed? Yes No <u>X</u>   |  |                                              |                                                   |                            |                 |              |
| If Yes: Pump Manufacturer's name Model No. HP Volts   |  |                                              |                                                   |                            |                 |              |
| Depth of Pump Intake ft. Pumps Capacity rated at gal./min.   |  |                                              |                                                   |                            |                 |              |
| Type of pump: 1 Submersible 2 Turbine 3 Jet 4 Centrifugal 5 Reciprocating 6 Other   |  |                                              |                                                   |                            |                 |              |
| 6 CONTRACTOR'S OR LANDOWNER'S CERTIFICATION: This water well was (1) constructed, (2) reconstructed, or (3) plugged under my jurisdiction and was   |  |                                              |                                                   |                            |                 |              |
| completed on <u>8</u> month <u>7</u> day <u>79</u> year   |  |                                              |                                                   |                            |                 |              |
| and this record is true to the best of my knowledge and belief. Kansas Water Well Contractor's License No. <u>Wichita Water Dept.</u>   |  |                                              |                                                   |                            |                 |              |
| This Water Well Record was completed on <u>19</u> month <u>9</u> day <u>81</u> year under the business   |  |                                              |                                                   |                            |                 |              |
| name of <u>Equus Beds GMD #2</u> by (signature)   |  |                                              |                                                   |                            |                 |              |
| 7 LOCATE WELL'S LOCATION WITH AN "X" IN SECTION BOX:   |  | FROM                                         | TO                                                | LITHOLOGIC LOG             | FROM            | TO           |
|   |  | 0                                            | 4                                                 | Top soil                   |                 |              |
|   |  | 4                                            | 12                                                | Clay-brown, gray           |                 |              |
|   |  | 12                                           | 29                                                | Sand & gravel-green, white |                 |              |
|   |  | 29                                           | 52                                                | Clay-green to tan          |                 |              |
|   |  | 52                                           | 62                                                | Sand & gravel-tan          |                 |              |
|   |  | 62                                           | 67                                                | Clay-green                 |                 |              |
|   |  | 67                                           | 78                                                | Sand & gravel-white        |                 | EB - 19B     |
|   |  | 78                                           | 85                                                | Clay-tan                   |                 |              |
| ELEVATION:   |  |                                              |                                                   |                            |                 |              |
| Depth(s) Groundwater Encountered 1. ft. 2. ft. 3. ft. 4. ft. (Use a second sheet if needed)   |  |                                              |                                                   |                            |                 |              |
| INSTRUCTIONS: Use typewriter or ball point pen, please press firmly and PRINT clearly. Please fill in blanks, underline or circle the correct answers. Send top three copies to Kansas Department of Health and Environment, Division of Environment, Water Well Contractors, Topeka, KS 66620. Send one to WATER WELL OWNER and retain one for your records. |  |                                              |                                                   |                            |                 |              |

OFFICE USE ONLY

T

R

EW

SEC.

1/4


1/4

1/4

USE TYPEWRITER OR BALL  
POINT PEN-PRESS FIRMLY,  
PRINT CLEARLY.

WATER WELL RECORD  
KSA 82a-1201-1215

Kansas Department of Health and  
Environment-Division of Environment  
(Water well Contractors)  
Topeka, Kansas 66620
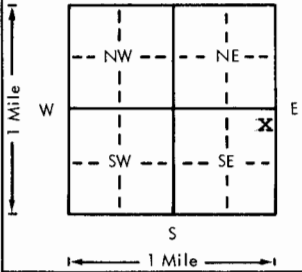
|   |              |                         |   |   |                                  |   |
|---|--------------|-------------------------|---|---|----------------------------------|---|
| 1. Location of well:   |              | County<br><b>Harvey</b> | Fraction<br><b>NE</b><br><b>NE 1/4 SE 1/4 SE 1/4</b>   | Section number<br><b>15</b>   | Township number<br><b>T 24 S</b> | Range number<br><b>R 3 E</b>   |
| 2. Distance and direction from nearest town or city:<br><b>2 mi. east - 4 1/2 south of Burrton</b><br>Street address of well location if in city:    |              |                         |   | 3. Owner of well: <b>Equus Beds Groundwater Management District No. 2</b><br>R.R. or street: <b>243 Main</b><br>City, state, zip code: <b>Halstead, Kansas 67056</b>   |                                  |   |
| 4. Locate with "X" in section below:   |              | Sketch map:             |   | 6. Bore hole dia. <b>4</b> in. Completion date <b>8/7/79</b><br>Well depth <b>78</b> ft.   |                                  |   |
|                                                                      |              |                         |   | 7. <input type="checkbox"/> Cable tool <input checked="" type="checkbox"/> Rotary <input type="checkbox"/> Driven <input type="checkbox"/> Dug<br><input type="checkbox"/> Hollow rod <input type="checkbox"/> Jetted <input type="checkbox"/> Bored <input type="checkbox"/> Reverse rotary                                                           |                                  |   |
|   |              |                         |   | 8. Use: <input type="checkbox"/> Domestic <input type="checkbox"/> Public supply <input type="checkbox"/> Industry<br><input type="checkbox"/> Irrigation <input type="checkbox"/> Air conditioning <input type="checkbox"/> Stock<br><input type="checkbox"/> Lawn <input type="checkbox"/> Oil field water <input checked="" type="checkbox"/> Other |                                  |   |
| 5. Type and color of material   |              |                         |   | From   | To                               | 9. Casing: Material <input type="checkbox"/> Height: Above or below<br>Threaded <input type="checkbox"/> Welded <input type="checkbox"/> Surface <b>24</b> in.<br>RMP <input type="checkbox"/> PVC <input checked="" type="checkbox"/> Weight <input type="checkbox"/> lbs./ft.<br>Dia. <b>2</b> in. to <b>75</b> ft. depth Wall Thickness: inches or<br>Dia. <input type="checkbox"/> in. to <input type="checkbox"/> ft. depth gage No. <b>Sch 40</b>                                                                                      |
| Top soil   |              |                         |   | 0   | 4                                | 10. Screen: Manufacturer's name <b>Johnson</b><br>Type <b>well point</b> Dia. <b>1.25 in.</b><br>Slot/gauze <b>10</b> Length <b>36 in.</b><br>Set between <b>75</b> ft. and <b>78</b> ft.<br>Gravel pack? <b>no</b> Size range of material   |
| Clay brown - gray   |              |                         |   | 4   | 12                               | 11. Static water level: <input type="checkbox"/> mo./day/yr.<br><input type="checkbox"/> ft. below land surface Date   |
| Sand & gravel green - white   |              |                         |   | 12   | 29                               | 12. Pumping level below land surfaces:<br><input type="checkbox"/> ft. after <input type="checkbox"/> hrs. pumping <input type="checkbox"/> g.p.m.<br><input type="checkbox"/> ft. after <input type="checkbox"/> hrs. pumping <input type="checkbox"/> g.p.m.<br>Estimated maximum yield <input type="checkbox"/> g.p.m.   |
| Clay green to tan   |              |                         |   | 29   | 52                               | 13. Water sample submitted: <input type="checkbox"/> mo./day/yr.<br><input type="checkbox"/> Yes <input checked="" type="checkbox"/> No Date   |
| Sand & gravel tan   |              |                         |   | 52   | 62                               | 14. Well head completion:<br><input type="checkbox"/> Pitless adapter <input type="checkbox"/> Inches above grade   |
| Clay green   |              |                         |   | 62   | 67                               | 15. Well grouted? <b>yes</b><br>With: <input checked="" type="checkbox"/> Neat cement <input type="checkbox"/> Bentonite <input type="checkbox"/> Concrete<br>Depth: From <b>0</b> ft. to <b>5</b> ft.   |
| Sand & gravel white   |              |                         |   | 67   | 78                               | 16. Nearest source of possible contamination:<br>ft. <input type="checkbox"/> Direction <input type="checkbox"/> Type <input type="checkbox"/><br>Well disinfected upon completion? <input type="checkbox"/> Yes <input checked="" type="checkbox"/> No   |
| Clay tan   |              |                         |   | 78   | 85                               | 17. Pump: <input checked="" type="checkbox"/> Not installed<br>Manufacturer's name <input type="checkbox"/><br>Model number <input type="checkbox"/> HP <input type="checkbox"/> Volts <input type="checkbox"/><br>Length of drop pipe <input type="checkbox"/> ft. capacity <input type="checkbox"/> g.p.m.<br>Type:<br><input type="checkbox"/> Submersible <input type="checkbox"/> Turbine<br><input type="checkbox"/> Jet <input type="checkbox"/> Reciprocating<br><input type="checkbox"/> Centrifugal <input type="checkbox"/> Other |
| (Use a second sheet if needed)   |              |                         |   |   |                                  |   |
| 18. Elevation:   | 19. Remarks: |                         | 20. Water well contractor's certification:<br>This well was drilled under my jurisdiction and this report is true to the best of my knowledge and belief.<br><b>Equus Beds GMD #2</b><br>Business name <input type="checkbox"/> License No. <input type="checkbox"/><br>Address <b>243 Main, Halstead, Ks.</b><br>Signed <b>Thomas C. Webb</b> Date <b>8/12/79</b><br>Authorized representative |   |                                  |   |
| Topography:<br><input type="checkbox"/> Hill<br><input type="checkbox"/> Slope<br><input type="checkbox"/> Upland<br><input type="checkbox"/> Valley |              | <b>EB - 19B</b>         |   |   |                                  |   |