USE TYPEWRITER OR BALL POINT PEN-PRESS FIRMLY, PRINT CLEARLY.

WATER WELL RECORD
KSA 82a-1201-1215

Kansas Department of Health and Environment-Division of Environment
(Water well Contractors)
Topeka, Kansas 66620

1. Location of well:	County	Fraction	Section number	Township number	Range number
	Harvey	1/4 NE 1/4 NW 1/4	17	T 24 S	R 3W E/W

2. Distance and direction from nearest town or city:
6 miles North of Mt. Hope on the Burrton Rd,
Street address of well location if in city:
then 3/4 West, then ¼ South. Burrton, KS

3. Owner of well: Milton Boyle
R.R. or street:
City, state, zip code: Burrton, Kansas

4. Locate with "X" in section below: Sketch map:

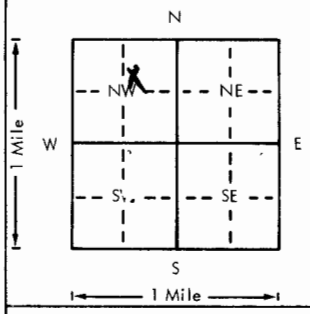

6. Bore hole dia. 11 in. Completion date
Well depth 65 ft. 9-11-78

7. __ Cable tool X Rotary __ Driven __ Dug
__ Hollow rod __ Jetted __ Bored __ Reverse rotary

8. Use: __ Domestic __ Public supply __ Industry
X Irrigation __ Air conditioning __ Stock
__ Lawn __ Oil field water __ Other

9. Casing: Material PVC Height: Above or below ///
Threaded ___ Welded ___ Surface 12 in.
RMP ___ PVC X Weight 3.96 lbs./ft.
Dia. 6 in. to 65 ft. depth Wall Thickness: inches or
Dia. ___ in. to ___ ft. depth gage No. .316

5. Type and color of material	From	To
Sandy Topsoil	0	2
Brown clay	2	7
Fine sand	7	20
Coarse sand	20	40
Light tan clay mixed with fine sand	40	60
Fine sand	60	65
(Use a second sheet if needed)		

10. Screen: Manufacturer's name
PVC NSF approved 200 PSI
Type PVC 200 PSI Dia. 6"
Slot/gauze /// .06 Length 40'
Set between 25 ft. and 65 ft.
___ ft. and ___ ft.
Gravel pack? yes Size range of material ¼-1/8"

11. Static water level: mo./day/yr.
7 ft. below land surface Date 9-11-78

12. Pumping level below land surfaces:
___ ft. after ___ hrs. pumping ___ g.p.m.
___ ft. after ___ hrs. pumping ___ g.p.m.
Estimated maximum yield ___ g.p.m.

13. Water sample submitted: mo./day/yr.
___ Yes ___ No Date

14. Well head completion: capped
___ Pitless adapter 12 Inches above grade

15. Well grouted? yes 1-2fine sand mix
With: ___ Neat cement ___ Bentonite X Concrete
Depth: From 0 ft. to 10 ft.

16. Nearest source of possible contamination:
ft. ___ Direction ___ Type None
Well disinfected upon completion? X Yes ___ No

17. Pump: X Not installed
Manufacturer's name
Model number ___ HP ___ Volts ___
Length of drop pipe ___ ft. capacity ___ g.p.m.
Type:
___ Submersible ___ Turbine
___ Jet ___ Reciprocating
___ Centrifugal ___ Other

18. Elevation:

Topography:
___ Hill
___ Slope
___ Upland
___ Valley

19. Remarks:
Flat ground
No apparent source for contamination.

20. Water well contractor's certification:
This well was drilled under my jurisdiction and this report is true to the best of my knowledge and belief.
Harp Well & Pump 236
Business name License No.
Address Wichita, Kansas 67209
Signed M. Arnold Date 9-24-78
Authorized representative

24 T - 30 R E W - 17 Sec - NENW 1/4 1/4 1/4

Forward the white, blue and pink copies to the Department of Health and Environment

Form WWC-5