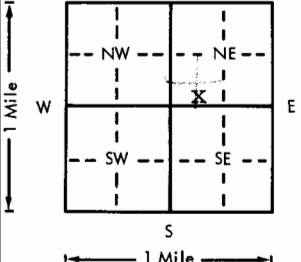


USE TYPEWRITER OR BALL
POINT PEN-PRESS FIRMLY,
PRINT CLEARLY.

WATER WELL RECORD
KSA 82a-1201-1215

Kansas Department of Health and
Environment-Division of Environment
(Water well Contractors)
Topeka, Kansas 66620

X Location of well:		County Harvey	Fraction S 1/2 SW 1/4 NE 1/4	Section number 21	Township number T 24 S	Range number R 3W E 1
X Distance and direction from nearest town or city: 1/2 m N. Patterson		3. Owner of well: Eugene Wolfe		R.R. or street: of the elevator in Mt. Hope,		
Street address of well location if in city: 1 North, 1/2 East		state, zip code: Kansas		Mt. Hope, Kansas		
4. Locate with "X" in section below: Kansas		Sketch map: #2 Well		6. Bore hole dia. 30 in. Completion date _____ Well depth 59 ft. 5-9-77		
		7. Cable tool _____ Rotary _____ Driven _____ Dug _____ Hollow rod _____ Jetted _____ Bored ☒ Reverse rotary				
		8. Use: _____ Domestic _____ Public supply _____ Industry _____ ☒ Irrigation _____ Air conditioning _____ Stock _____ Lawn _____ Oil field water _____ Other _____				
5. Type and color of material		From	To	9. Casing: Transite Height: Above or below _____ See #19 Welded _____ Surface 12 in. RMP _____ PVC _____ Weight 37 lbs./ft. Dia. 16 in. to 59 ft. depth Wall Thickness: inches or _____ Dia. _____ in. to _____ ft. depth gage No. 3/4"		
Clay		0	6	10. Screen: Manufacturer's name _____ Johnson Type irrigator Dia. 16" Slot/gauge 100 Length 20' Set between 39 ft. and 59 ft. ft. and _____ ft. Gravel pack? yes Size range of material 1/4-1/8"		
Medium to coarse Sand and gravel		6	55	11. Static water level: _____ mo./day/yr. 6 ft. below land surface Date 5-9-77		
Medium to coarse sand and gravel with some clay		55	59	12. Pumping level below land surfaces: _____ ft. after _____ hrs. pumping _____ g.p.m. _____ ft. after _____ hrs. pumping _____ g.p.m. Estimated maximum yield _____ g.p.m.		
				13. Water sample submitted: _____ mo./day/yr. Yes _____ No _____ Date _____		
				14. Well head completion: _____ Pitless adapter 12 inches above grade		
				15. Well grouted? yes 1-2 fine sand mix With: _____ Neat cement _____ Bentonite ☒ Concrete Depth: From 0 ft. to 10 ft.		
				16. Nearest source of possible contamination: NONE ft. _____ Direction _____ Type _____ Well disinfected upon completion? ☒ Yes _____ No _____		
				17. Pump: _____ Not installed Manufacturer's name Hydraulic Products Model number 10HHQ HP 50 Volts 460 Length of drop pipe _____ ft. capacity 800 g.p.m. Type: _____ Submersible ☒ Turbine _____ _____ Jet _____ Reciprocating _____ _____ Centrifugal _____ Other _____		
(Use a second sheet if needed)						
18. Elevation:	19. Remarks: Flat Ground From #9 Banded But Joint No near apparent source for contamination.		20. Water well contractor's certification: This well was drilled under my jurisdiction and this report is true to the best of my knowledge and belief. Harp Well & Pump 236 Business name 215 South Tyler Road License No. _____ Address _____ Signed M. Arnold Date 8-10-77 Authorized representative			
Topography: ____ Hill ____ Slope ____ Upland ____ Valley						