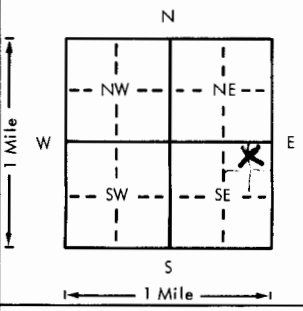


USE TYPEWRITER OR BALL
POINT PEN-PRESS FIRMLY,
PRINT CLEARLY.

WATER WELL RECORD
KSA 82a-1201-1215

Kansas Department of Health and
Environment-Division of Environment
(Water well Contractors)
Topeka, Kansas 66620

1. Location of well:		County Harvey	X Section NE 1/4 NE 1/4 SE 1/4	Section number 27	Township number T 24 S	Range number R 3 E
2. Distance and direction from nearest town or city: Street address of well location if in city: 1 S 1 E 1/2 N Patterson			3. Owner of well: Fred Soper R.R. or street: 2541 Bobwhite City, state, zip code: Wichita, KS			
4. Locate with "X" in section below: 			6. Bore hole dia. 30 in. Completion date 6/24/79 Well depth 57 ft.			
5. Type and color of material			7. ☐ Cable tool ☐ Rotary ☐ Driven ☐ Dug ☐ Hollow rod ☐ Jetted ☐ Bored ☒ Reverse rotary			
			8. Use: ☐ Domestic ☐ Public supply ☐ Industry ☒ Irrigation ☐ Air conditioning ☐ Stock ☐ Lawn ☐ Oil field water ☐ Other			
			9. Casing: Material C-Asb Height: Above or below Threaded ☐ Welded ☐ Surface 12 in. RMP ☐ PVC ☐ Weight ☐ lbs./ft. Dia. 1 1/2 in. to 57 ft. depth Wall Thickness: inches or Dia. ☐ in. to ☐ ft. depth Gauge No. 3/4			
			10. Screen: Manufacturer's name Johnson Type Cement-Asb Dia. 1 1/2 in. Slot/gauze ☐ Length 19 1/2 ft. Set between 37 1/2 ft. and 57 ft. Gravel pack? ☒ Size range of material 3/8			
			11. Static water level: ☐ mo./day/yr. 21 ft. below land surface Date ☐			
(Use a second sheet if needed)			12. Pumping level below land surfaces: did not ☐ ft. after ☐ hrs. pumping ☐ g.p.m. ☐ ft. after ☐ hrs. pumping ☐ g.p.m. Estimated maximum yield ☐ g.p.m.			
			13. Water sample submitted: ☐ mo./day/yr. ☐ Yes ☒ No Date ☐			
			14. Well head completion: ☐ Pitless adapter 12 inches above grade			
			15. Well grouted? ☒ With: ☐ Neat cement ☐ Bentonite ☒ Concrete Depth: From 0 ft. to 10 ft.			
			16. Nearest source of possible contamination: none ft. ☐ Direction ☐ Type ☐ Well disinfected upon completion? ☐ Yes ☒ No			
18. Elevation:			17. Pump: ☒ Not installed Manufacturer's name ☐ Model number ☐ HP ☐ Volts ☐ Length of drop pipe ☐ ft. capacity ☐ g.p.m. Type: ☐ Submersible ☐ Turbine ☐ Jet ☐ Reciprocating ☐ Centrifugal ☐ Other			
			20. Water well contractor's certification: This well was drilled under my jurisdiction and this report is true to the best of my knowledge and belief. Weninger Irrigation 238 Business name Maize License No. ☐ Address ☐ Signed K. Weninger Date 6/26/79 Authorized representative			
			19. Remarks:			
			Topography: ☐ Hill ☐ Slope ☒ Upland ☐ Valley			