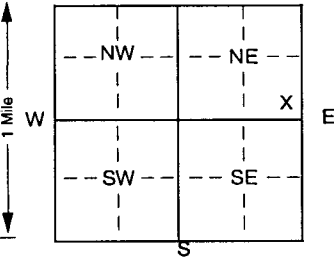


1 LOCATION OF WATER WELL:	Fraction	Section Number	Township Number	Range Number
County: Harvey	SE 1/4 SE 1/4 NE 1/4	14	T 24 S	R 3 E (W)

Distance and direction from nearest town or city street address of well if located within city?

Approximately 3 miles east and 4 1/2 miles south of Burrton

2 WATER WELL OWNER:	City of Wichita	Board of Agriculture, Division of Water Resources
RR#, St. Address, Box #	455 N. Main	Application Number:
City, State, ZIP Code	Wichita, KS 67202	

3 LOCATE WELL'S LOCATION WITH AN "X" IN SECTION BOX:	4 DEPTH OF COMPLETED WELL 152 ft. ELEVATION: unknown
	Depth(s) Groundwater Encountered 1 ft. 2 ft. 3 ft. ft.
	WELL'S STATIC WATER LEVEL not checked ft. below land surface measured on mo/day/yr
	Pump test data: Well water was not checked ft. after hours pumping gpm
	Est. Yield unknown gpm: Well water was ft. after hours pumping gpm
	Bore Hole Diameter 6 in. to 240 ft., and in. to ft.
	WELL WATER TO BE USED AS:
	5 Public water supply 8 Air conditioning 11 Injection well
	1 Domestic 3 Feedlot 6 Oil field water supply 9 Dewatering 12 Other (specify below)
	2 Irrigation 4 Industrial 7 Domestic (lawn & garden) 10 Monitoring well Index Well
	Was a chemical/bacteriological sample submitted to Department? Yes No ☒ If yes, mo/day/yr sample was submitted
	Water Well Disinfected? Yes No ☒

5 TYPE OF BLANK CASING USED:	5 Wrought iron	8 Concrete tile	CASING JOINTS: Glued ☒ Clamped
1 Steel	3 RMP (SR)	6 Asbestos-Cement	9 Other (specify below) Welded
2 PVC	4 ABS	7 Fiberglass	Threaded
Blank casing diameter 2 in. to 130 ft., Dia			in. to ft., Dia in. to ft.
Casing height above land surface 24 in., weight .96 lbs./ft. Wall thickness or gauge No .218			
TYPE OF SCREEN OR PERFORATION MATERIAL:	7 PVC	10 Asbestos-cement	
1 Steel	3 Stainless steel	5 Fiberglass	8 RMP (SR)
2 Brass	4 Galvanized steel	6 Concrete tile	9 ABS
SCREEN OR PERFORATION OPENINGS ARE:	5 Gauzed wrapped	8 Saw cut	11 None (open hole)
1 Continuous slot	3 Mill slot	6 Wire wrapped	9 Drilled holes
2 Louvered shutter	4 Key punched	7 Torch cut	10 Other (specify) ft.
SCREEN-PERFORATED INTERVALS:	From 130 ft. to 150 ft., From		ft. to ft.
GRAVEL PACK INTERVALS:	From 125 ft. to 152 ft., From		ft. to ft.
	From ft. to ft., From		ft. to ft.

6 GROUT MATERIAL:	1 Neat cement	2 Cement grout	3 Bentonite	4 Other Bentonite Holeplug
Grout Intervals: From 0 ft. to 118 ft., From				ft. to ft., From 118 ft. to 125 ft.
What is the nearest source of possible contamination:				
1 Septic tank	4 Lateral lines	7 Pit privy	10 Livestock pens	14 Abandoned water well
2 Sewer lines	5 Cess pool	8 Sewage lagoon	11 Fuel storage	15 Oil well/Gas well
3 Watertight sewer lines	6 Seepage pit	9 Feedyard	12 Fertilizer storage	16 Other (specify below)
			13 Insecticide storage	None known
Direction from well?			How many feet?	

FROM	TO	LITHOLOGIC LOG	FROM	TO	PLUGGING INTERVALS
0	2	Topsoil	196	237	Clay, brown, flaky
2	57	Sand and gravel, coarse, medium, fine	237	240	Shale, red and green
57	61	Clay, green			
61	95	Sand and gravel, medium, fine, very fine			
95	97	Clay, green			
97	100	Clay, gray, green			
100	108	Sand, medium, fine			
108	110	Clay, gray			
110	134	Sand and gravel, medium, fine			
134	139	Clay, gray, green			
139	154	Sand, medium, fine, very fine			
154	187	Clay, dark gray			
187	191	Clay, green			
191	196	Clay, dark gray			

7 CONTRACTOR'S OR LANDOWNER'S CERTIFICATION: This water well was (1) constructed (2) reconstructed or (3) plugged under my jurisdiction and was completed on (mo/day/year) 7-5-01 and this record is true to the best of my knowledge and belief. Kansas
Water Well Contractor's License No 185 This Water Well Record was completed on (mo/day/yr) 7-21-01
under the business name of Clarke Well & Equipment, Inc. by (signature) [Signature]

INSTRUCTIONS: Use typewriter or ball point pen. PLEASE PRESS FIRMLY and PRINT clearly. Please fill in blanks, underline or circle the correct answers. Send top three copies to Kansas Department of Health and Environment, Bureau of Water, Topeka, Kansas 66620-0001. Telephone 785-296-5524. Send one to WATER WELL OWNER and retain one for your records. Fee of \$5.00 for each constructed well.