82 5724 WATER WELL RECORD Form WWC-5 KSA 82a-1212 ID No. IW-25C

1 LOCATION OF WATER WELL:

County:	Fraction	Section Number	Township Number	Range Number
Harvey	SE 1/4 SW 1/4 SE 1/4	35	T 24 S	R 3 E (W)

Distance and direction from nearest town or city street address of well if located within city?
Approximately 6 miles south and 5 1/4 miles west of Halstead

2 WATER WELL OWNER: City of Wichita
RR#, St. Address, Box # : 455 N. Main
City, State, ZIP Code : Wichita, KS 67202

Board of Agriculture, Division of Water Resources
Application Number:

3 LOCATE WELL'S LOCATION WITH AN "X" IN SECTION BOX:

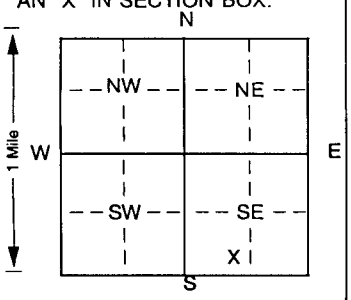

4 DEPTH OF COMPLETED WELL 77 ft. ELEVATION: unknown

Depth(s) Groundwater Encountered 1 ____ ft. 2 ____ ft. 3 ____ ft.
WELL'S STATIC WATER LEVEL not checked ft. below land surface measured on mo/day/yr ____
Pump test data: Well water was not checked ft. after ____ hours pumping ____ gpm
Est. Yield unknown gpm: Well water was ____ ft. after ____ hours pumping ____ gpm
Bore Hole Diameter 6 in. to 83 ft., and ____ in. to ____ ft.

WELL WATER TO BE USED AS:
1 Domestic 3 Feedlot 5 Public water supply 6 Oil field water supply 7 Domestic (lawn & garden) 8 Air conditioning 9 Dewatering 10 Monitoring well 11 Injection well 12 Other (specify below) Index Well
2 Irrigation 4 Industrial

Was a chemical/bacteriological sample submitted to Department? Yes ____ No ✓ If yes, mo/day/yrs sample was submitted
Water Well Disinfected? Yes ____ No ✓

5 TYPE OF BLANK CASING USED:
1 Steel 3 RMP (SR) 5 Wrought iron 8 Concrete tile
(2) PVC 4 ABS 6 Asbestos-Cement 9 Other (specify below)
7 Fiberglass

CASING JOINTS: Glued ✓ Clamped ____
Welded ____
Threaded ____

Blank casing diameter 2 in. to 65 ft., Dia ____ in. to ____ ft., Dia ____ in. to ____ ft
Casing height above land surface 24 in., weight .96 lbs./ft. Wall thickness or gauge No .218

TYPE OF SCREEN OR PERFORATION MATERIAL:
1 Steel 3 Stainless steel 5 Fiberglass (7) PVC 10 Asbestos-cement
2 Brass 4 Galvanized steel 6 Concrete tile 8 RMP (SR) 11 Other (specify) ____
9 ABS 12 None used (open hole)

SCREEN OR PERFORATION OPENINGS ARE:
1 Continuous slot (3) Mill slot 5 Gauzed wrapped 8 Saw cut 11 None (open hole)
2 Louvered shutter 4 Key punched 6 Wire wrapped 9 Drilled holes
7 Torch cut 10 Other (specify) ____

SCREEN-PERFORATED INTERVALS: From 65 ft. to 75 ft., From ____ ft. to ____ ft.
From ____ ft. to ____ ft., From ____ ft. to ____ ft.
GRAVEL PACK INTERVALS: From 55 ft. to 83 ft., From ____ ft. to ____ ft.
From ____ ft. to ____ ft., From ____ ft. to ____ ft.

6 GROUT MATERIAL: (1) Neat cement 2 Cement grout 3 Bentonite 4 Other Bentonite Holeplug

Grout Intervals: From 0 ft. to 45 ft., From ____ ft. to ____ ft., From 45 ft. to 55 ft.

What is the nearest source of possible contamination:
1 Septic tank 4 Lateral lines 7 Pit privy 10 Livestock pens 14 Abandoned water well
2 Sewer lines 5 Cess pool 8 Sewage lagoon 11 Fuel storage 15 Oil well/Gas well
3 Watertight sewer lines 6 Seepage pit 9 Feedyard 12 Fertilizer storage 16 Other (specify below) None known
13 Insecticide storage

Direction from well? How many feet?

FROM	TO	LITHOLOGIC LOG	FROM	TO	PLUGGING INTERVALS
0	5	Topsoil			
5	9	Clay, tan			
9	51	Sand and gravel, coarse, medium, fine			
51	56	Clay, tan and brown			
56	63	Sand and gravel, coarse, medium, fine			
63	67	Clay, tan			
67	77	Sand and gravel, medium, fine			
77	83	Shale, green, limey			

7 CONTRACTOR'S OR LANDOWNER'S CERTIFICATION: This water well was (1) constructed, (2) reconstructed, or (3) plugged under my jurisdiction and was completed on (mo/day/year) 8-6-01 and this record is true to the best of my knowledge and belief. Kansas Water Well Contractor's License No 185 This Water Well Record was completed on (mo/day/yr) 8-23-01
under the business name of Clarke Well & Equipment, Inc. by (signature) [signature]

INSTRUCTIONS: Use typewriter or ball point pen. *PLEASE PRESS FIRMLY* and *PRINT* clearly. Please fill in blanks, underline or circle the correct answers. Send top three copies to Kansas Department of Health and Environment, Bureau of Water, Topeka, Kansas 66620-0001. Telephone 785-296-5524. Send one to WATER WELL OWNER and retain one for your records. Fee of $5.00 for each constructed well.