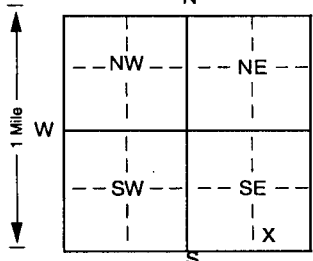


1 LOCATION OF WATER WELL:	Fraction	Section Number	Township Number	Range Number
County: Harvey	SW 1/4 SE 1/4 SE 1/4	33	T 24 S	R 3 E

Distance and direction from nearest town or city street address of well if located within city?

Approximately 3 miles north and 3/4 mile east of Mt. Hope

2 WATER WELL OWNER:	City of Wichita	Board of Agriculture, Division of Water Resources
RR#, St. Address, Box #	: 455 N. Main	Application Number:
City, State, ZIP Code	: Wichita, KS 67202	

3 LOCATE WELL'S LOCATION WITH AN "X" IN SECTION BOX:	4 DEPTH OF COMPLETED WELL	159	ft. ELEVATION:	unknown
	Depth(s) Groundwater Encountered	1	ft. 2	ft. 3
	WELL'S STATIC WATER LEVEL not checked ft. below land surface measured on mo/day/yr			
	Pump test data: Well water was not checked ft. after hours pumping gpm			
	Est. Yield unknown gpm: Well water was ft. after hours pumping gpm			
	Bore Hole Diameter 6 in. to 185 ft., and in. to ft.			
WELL WATER TO BE USED AS:				
1 Domestic 3 Feedlot 6 Oil field water supply 8 Air conditioning 11 Injection well				
2 Irrigation 4 Industrial 7 Domestic (lawn & garden) 10 Monitoring well 12 Other (specify below)				
Was a chemical/bacteriological sample submitted to Department? Yes No If yes, mo/day/yr sample was submitted				
Water Well Disinfected? Yes No				

5 TYPE OF BLANK CASING USED:	5 Wrought iron	8 Concrete tile	CASING JOINTS: Glued Clamped
1 Steel	3 RMP (SR)	6 Asbestos-Cement	9 Other (specify below)
2 PVC	4 ABS	7 Fiberglass	10 Asbestos-cement
Blank casing diameter	2 in. to 137 ft., Dia	in. to ft., Dia	in. to ft.
Casing height above land surface	24 in., weight	.90 lbs./ft. Wall thickness or gauge No	.218
TYPE OF SCREEN OR PERFORATION MATERIAL:			
1 Steel	3 Stainless steel	5 Fiberglass	7 RMP (SR)
2 Brass	4 Galvanized steel	6 Concrete tile	9 ABS
SCREEN OR PERFORATION OPENINGS ARE:			
1 Continuous slot	3 Mill slot	5 Gauzed wrapped	8 Saw cut
2 Louvered shutter	4 Key punched	6 Wire wrapped	9 Drilled holes
SCREEN-PERFORATED INTERVALS:			
GRAVEL PACK INTERVALS:			

6 GROUT MATERIAL:	1 Neat cement	2 Cement grout	3 Bentonite	4 Other
Grout Intervals: From	0	ft. to 127	ft., From	ft. to ft., From ft. to ft.
What is the nearest source of possible contamination:				
1 Septic tank	4 Lateral lines	7 Pit privy	10 Livestock pens	14 Abandoned water well
2 Sewer lines	5 Cess pool	8 Sewage lagoon	11 Fuel storage	15 Oil well/Gas well
3 Watertight sewer lines	6 Seepage pit	9 Feedyard	12 Fertilizer storage	16 Other (specify below)
Direction from well? How many feet?				

FROM	TO	LITHOLOGIC LOG	FROM	TO	PLUGGING INTERVALS
0	1	Topsoil			
1	13	Sand and gravel, coarse, medium, fine			
13	18	Clay, black, silty, soft			
18	21	Clay, dark green and bluish-green			
21	43	Sand and gravel, coarse, medium, fine			
43	58	Clay, tannish brown			
58	64	Sand and gravel, medium, fine			
64	66	Clay, tannish brown			
66	74	Sand and gravel, medium, fine			
74	92	Clay, reddish brown			
92	175	Sand and gravel, coarse, medium, fine, loose, very clean			
175	180	Cemented sand, shale streaks			
180	185	Shale, black			

7 CONTRACTOR'S OR LANDOWNER'S CERTIFICATION:	This water well was (1) constructed (2) reconstructed or (3) plugged under my jurisdiction and was completed on (mo/day/year) 9-27-01 and this record is true to the best of my knowledge and belief. Kansas Water Well Contractor's License No 185 This Water Well Record was completed on (mo/day/yr) 10-3-01 under the business name of Clarke Well & Equipment, Inc. by (signature)
--	---