WATER WELL RECORD Form WWC-5 KSA 82a-1212 ID No. RB1 PZ (S)

1 LOCATION OF WATER WELL: County: Harvey | Fraction: NE ¼ NE ¼ NE ¼ | Section Number: 2 | Township Number: T 24 S | Range Number: R 3 W

Distance and direction from nearest town or city street address of well if located within city?
325 feet south of center of SW 36th Street, 550 feet west of center of Willow Lake Road

2 WATER WELL OWNER: City of Wichita
RR#, St. Address, Box # : 6016 S. Spring Lake Road
City, State, ZIP Code : Halstead, Kansas 67056
Board of Agriculture, Division of Water Resources
Application Number:

3 LOCATE WELL'S LOCATON WITH AN "X" IN SECTION BOX:

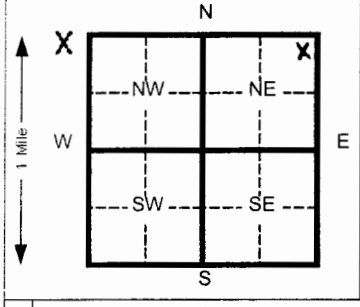

4 DEPTH OF COMPLETED WELL 65 ft. ELEVATION: 1426
Depth(s) Groundwater Encountered 1 19.2 ft. 2 ft. 3 ft.
WELL'S STATIC WATER LEVEL 19.2 ft. below land surface measured on mo/day/yr 8/21/2006
Pump test data: Well water was ft. after hours pumping gpm
Est. Yield gpm: Well water was ft. after hours pumping gpm
Bore Hole Diameter 8 in. to 65 ft. and in. to ft.
WELL WATER TO BE USED AS: 5 Public water supply 8 Air conditioning 11 Injection well
1 Domestic 3 Feed lot 6 Oil field water supply 9 Dewatering 12 Other (Specify below)
2 Irrigation 4 Industrial 7 Lawn and garden (domestic) (10) Monitoring well
Was a chemical/bacteriological sample submitted to Department? Yes No X If yes, mo/day/yr sample was submitted Water Well Disinfected? Yes No X

5 TYPE OF BLANK CASING USED: 5 Wrought Iron 8 Concrete tile CASING JOINTS: Glued Clamped
1 Steel 3 RMP (SR) 6 Asbestos-Cement 9 Other (specify below) Welded
(2) PVC 4 ABS 7 Fiberglass Threaded X
Blank casing diameter 2 in. to 55 ft., Dia in. to ft., Dia in. to ft.
Casing height above land surface 31 in., weight 0.68 lbs./ft. Wall thickness or gauge No. Sch. 40

TYPE OF SCREEN OR PERFORATION MATERIAL: (7) PVC 10 Asbestos-cement
1 Steel 3 Stainless steel 5 Fiberglass 8 RMP (SR) 11 Other (specify)
2 Brass 4 Galvanized steel 6 Concrete tile 9 ABS 12 None used (open hole)
SCREEN OR PERFORATION OPENINGS ARE: 5 Gauzed wrapped 8 Saw cut 11 None (open hole)
1 Continuous slot (3) Mill slot 6 Wire wrapped 9 Drilled holes
2 Louvered shutter 4 Key punched 7 Torch cut 10 Other (specify)
SCREEN-PERFORATED INTERVALS: From 55 ft. to 65 ft. From ft. to ft.
From ft. to ft. From ft. to ft.
GRAVEL PACK INTERVALS: From 52 ft. to 65 ft. From ft. to ft.
From ft. to ft. From ft. to ft.

6 GROUT MATERIAL: 1 Neat cement 2 Cement grout (3) Bentonite 4 Other
Grout Intervals From 0 ft. to 52 ft. From ft. to ft. From ft. to ft.
What is the nearest source of possible contamination:
1 Septic tank 4 Lateral lines 7 Pit privy 10 Livestock pens 14 Abandoned water well
2 Sewer lines 5 Cess pool 8 Sewage lagoon 11 Fuel storage 15 Oil well/ Gas well
3 Watertight sewer lines 6 Seepage pit 9 Feedyard 12 Fertilizer storage 16 Other (specify below)
13 Insecticide storage
Direction from well? How many feet?

FROM	TO	CODE	LITHOLOGIC LOG	FROM	TO	PLUGGING INTERVALS
			see attached log			

7 CONTRACTOR'S OR LANDOWNER'S CERTIFICATION: This water well was (1) constructed, (2) reconstructed, or (3) plugged under my jurisdiction and was completed on (mo/day/yr) 07/27/2006 and this record is true to the best of my knowledge and belief. Kansas Water Well Contractor's License No. 102 This Water Well Record was completed on (mo/day/yr) 08/21/2006 under the business name of Layne Christensen Company by (signature)

INSTRUCTIONS: Please fill in blanks and circle the correct answers. Send three copies to Kansas Department of Health and Environment, Bureau of Water, 1000 S W Jackson St., Ste. 420, Topeka, Kansas 66612-1367. Telephone: 913-296-5545. Send one to WATER WELL OWNER and retain one for your records.

OFFICE USE ONLY T R SEC

TEST HOLE REPORT

LAYNE Western, a Div. of
LAYNE Christensen
Wichita, Kansas

Contract Name: Wichita ASR	Test Hole No. RB1PZ (s)
	Date: July 27, 2006
	Driller: M. Leslie

Location of Test Hole:	Elevation of Test Hole:
	Static Water Level:
Page 1	
	Measured Hours After Completion

From	To	Description of Strata
0	5	orange, olive sand, fine to coarse with gravel, clay lens
5	10	orange, olive sand, fine to coarse with gravel, clay lens
10	15	orange, olive sand, fine to coarse with gravel, slight clay
15	20	orange, olive sand, fine to coarse with gravel, slight clay
20	25	orange, olive sand, fine to coarse with gravel, slight clay
25	30	orange, olive sand, fine to coarse with gravel, slight clay
30	35	orange, olive sand, fine to coarse with gravel, slight clay
35	40	orange, olive sand, fine to coarse with gravel, slight clay
40	45	orange, olive sand, fine to coarse with gravel, slight clay
45	50	orange, olive sand, fine to coarse with gravel, slight clay
50	55	olive, sand, fine to coarse with gravel, clay lens
55	60	olive, sand, fine to coarse with gravel, clay lens
60	65	olive, sand, fine to coarse with gravel, clay lens