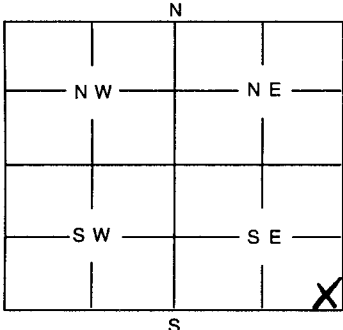


1	LOCATION OF WATER WELL:	Fraction	Section	Number	Township	Number	Range	Number
County: Reno		SE 1/4 SE 1/4 SE 1/4	18		26		7	W

Distance and direction from nearest town or city street address of well if located within city?

5 miles West of Pretty Prairie, Ks.

2	WATER WELL OWNER: Richard Graber	
RR #, St. Address, Box #: 4104 S. Herren Rd.		Board of Agriculture, Division of Water Resources
City, State, ZIP Code : Hutchinson, Ks. 67501		Application Number:

3	MARK WELL'S LOCATION WITH AN "X" IN SECTION BOX:	4	DEPTH OF WELL 10 @ 180 ft ft												
		WELL'S STATIC WATER LEVEL 40 ft. WELL WAS USED AS: <table border="0"> <tr> <td>1 Domestic</td> <td>5 Public Water Supply</td> <td>9 Dewatering</td> </tr> <tr> <td>2 Irrigation</td> <td>6 Oil Field Water Supply</td> <td>10 Monitoring Well</td> </tr> <tr> <td>3 Feedlot</td> <td>7 Domestic (Lawn & Garden)</td> <td>11 Injection Well</td> </tr> <tr> <td>4 Industrial</td> <td>8 Air Conditioning</td> <td>☒ Other Geo-thermal</td> </tr>
Was a chemical / bacteriological sample submitted to Department? Yes No ☒ If yes, mo/day/yr sample was submitted Water Well Disinfected: Yes No ☒															

5	TYPE OF BLANK CASING USED:	
1 Steel 3 RMP (SR) 5 Wrought 7 Fiberglass ☒ Other (Specify below) 2 PVC 4 ABS 6 Asbestos-Cement 8 Concrete Tile polyethylene		
Blank casing diameter 3/4 in. Was casing pulled? Yes No If yes, how much		
Casing height above or below land surface		

6	GROUT PLUG MATERIAL: 1 Neat cement 2 Cement grout ☒ Bentonite 4 Other																					
Grout Plug Intervals: From 3 ft. to 180 ft., From 3 ft. to 180 ft., From 3 ft. to 180 ft.																						
What is the nearest source of possible contamination:																						
<table border="0"> <tr> <td>1 Septic tank</td> <td>6 Seepage pit</td> <td>11 Fuel storage</td> <td>16 Other (specify below)</td> </tr> <tr> <td>☒ Sewer lines</td> <td>7 Pit privy</td> <td>12 Fertilizer storage</td> <td></td> </tr> <tr> <td>3 Watertight sewer lines</td> <td>8 Sewage lagoon</td> <td>13 Insecticide storage</td> <td></td> </tr> <tr> <td>4 Lateral lines</td> <td>9 Feedyard</td> <td>14 Abandoned water well</td> <td></td> </tr> <tr> <td>5 Cess Pool</td> <td>10 Livestock pens</td> <td>15 Oil well/Gas well</td> <td></td> </tr>
Direction from well? North How many feet? 100'																						

FROM	TO	PLUGGING MATERIALS
0	5	Topsoil
5	12	Clay, yellow
12	30	Sand, fine to coarse
30	36	Clay, yellow
36	47	Sand, fine to coarse
47	180	Shale, red
180	200	Shale, red w/fractures

7	CONTRACTOR'S OR LANDOWNER'S CERTIFICATION: This water well was plugged under my jurisdiction and was completed on (mo/day/year) 11/28/06 and this record is true to the best of my knowledge and belief. Kansas Water Well Contractor's License No. 138 This Water Well Record was completed on (mo/day/year) 12/7/06	
by (signature) Mike Peterson under the business name of Peterson Irrigation, Inc.		

INSTRUCTIONS: Use typewriter or ball point pen. Please press firmly and print clearly. Please fill in blanks, underline or circle the correct answers. Send top three copies to Kansas Department of Health and Environment, Bureau of Water, Topeka, Kansas 66620-0001. Telephone: 785/296-3565. Send one to Water Well Owner and retain one for your records.