WATER WELL PLUGGING RECORD Form WWC-5P KSA 82a-1212

LOCATION OF WATER WELL: HARVEY	Fraction	Section Number	Township Number	Range Number
	NE ¼ SE ¼ SE ¼	21	24 SOUTH	03 WEST

Distance and direction from nearest town or city street address of well if located within city?

APPROXIMATELY 0.50 MILES EAST AND 0.25 MILES NORTH OF PATTERSON, KS

WATER WELL OWNER:

RR#, St. Address, Box #: EQUUS BEDS GROUNDWATER MANAGEMENT DISTRICT NO. 2 313 SPRUCE ST.

City, State, ZIP Code: HALSTEAD, KS 67056

Board of Agriculture, Division of Water Resources

Application Number:

MARK WELL'S LOCATION WITH AN "X" IN SECTION BOX

N

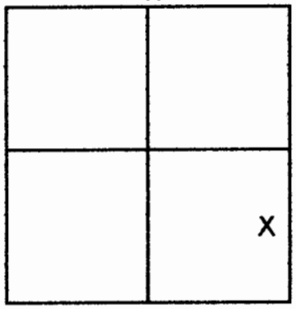

S

DEPTH OF WELL 18.7 ft.

WELL'S STATIC WATER LEVEL 6.05 ft.

WELL WAS USED AS:

1 Domestic 5 Public Water Supply 9 Dewatering
2 Irrigation 6 Oil Field Water Supply **10 Monitoring Well – EB18A**
3 Feedlot 7 Lawn and Garden Only 11 Injection Well
4 Industrial 8 Air Conditioning 12 Other

Was a chemical/bacteriological sample submitted to Department? Yes ☐ No ☒

If yes, mo/day/yr sample was submitted : / /

WaterWell Disinfected: Yes ☒ No ☐

TYPE OF BLANK CASING USED:

1 Steel 3 RMP (SR) 5 Wrought 7 Fiberglass 9 Other
2 PVC 4 ABS 6 Asbestos-Cement 8 Concrete Tile

Blank casing diameter 1.25 in. Was casing pulled? Yes ☒ No ☐ if yes, how much 8.7 ft bls

Casing height ~~above or~~ below land surface 8.7 feet.

GROUT PLUG MATERIAL: 1 Neat cement 2 Cement grout **3 Bentonite** 4 Other

Grout Plug Intervals: From 18.7 ft. to 4.0 ft.

What is the nearest source of possible contamination:

1 Septic tank 6 Seepage pit 11 Fuel Storage **16 Other – livestock pasture**
2 Sewer lines 7 Pit privy 12 Fertilizer storage
3 Watertight sewer lines 8 Sewage lagoon 13 Insecticide storage
4 Lateral lines 9 Feedyard 14 Abandoned water well
5 Cess Pool 10 Livestock pens 15 Oil well / Gas well

Direction from well? East How many feet? 100 ft.

FROM	TO	PLUGGING MATERIALS
18.7	4.0	Bentonite, HolePlug
4.0	0	Topsoil

Well casing separated at coupler when pulling well casing.

CONTRACTOR'S OR LANDOWNER'S CERTIFICATION: This water well was plugged under my jurisdiction and was completed on (mo/day/year) 11 / 30 / 2009 and this record is true to the best of my knowledge and belief. Kansas Water Well Contractor's License No. NA under the business name of Equus Beds GMD2

by (signature) Tim Boese GMD2 12-22-09

INSTRUCTIONS: Use typewriter or ball point pen. Please press firmly and print clearly. Please fill in blanks, and underline or circle the correct answers. Send top three copies to Kansas Department of Health and Environment, Bureau of Water, Topeka, Kansas 66620-0001. Telephone: 913/296-3565. Send one to Watrer Well Owner and retain one for your records.