WATER WELL PLUGGING RECORD Form WWC-5P KSA 82a-1212

LOCATION OF WATER WELL: HARVEY	Fraction	Section Number	Township Number	Range Number
	NW-SW-NW	34	24 SOUTH	03 WEST

Distance and direction from nearest town or city street address of well if located within city?

APPROXIMATELY 1.5 MILES SOUTH AND 0.5 MILES EAST OF PATTERSON, KS Latitude: 37.92239 Longitude: -97.64583 (NAD27)

WATER WELL OWNER: ROB KREHBIEL FARMS, INC.
C/O SUSAN KREHBIEL WILLIAM
RR#, St. Address, Box #: 31 SW RANDOLPH SQUARE
TOPEKA, KS 66611
City, State, ZIP Code:

Board of Agriculture, Division of Water Resources
Application Number: 45628

MARK WELL'S LOCATION WITH AN "X" IN SECTION BOX

N

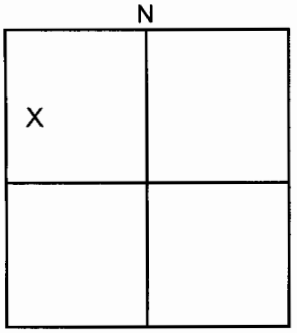

S

DEPTH OF WELL 26.8 ft.

WELL'S STATIC WATER LEVEL 5.6 ft.

WELL WAS USED AS:

1 Domestic 5 Public Water Supply 9 Dewatering
2 Irrigation 6 Oil Field Water Supply 10 Monitoring Well
3 Feedlot 7 Lawn and Garden Only 11 Injection Well
4 Industrial 8 Air Conditioning **12 Other - Recreation**

Was a chemical/bacteriological sample submitted to Department? Yes ☐ No ☒
If yes, mo/day/yr sample was submitted : / /

Water Well Disinfected: Yes ☒ No ☐

TYPE OF BLANK CASING USED:

1 Steel 3 RMP (SR) 5 Wrought 7 Fiberglass 9 Other
2 PVC 4 ABS 6 Asbestos-Cement 8 Concrete Tile

Blank casing diameter 5.0 in. Was casing pulled? Yes ☐ No ☒ if yes, how much 0.0 ft bls
Casing height ~~above or~~ below land surface 3 feet.

GROUT PLUG MATERIAL: 1 Neat cement 2 Cement grout **3 Bentonite** 4 Other

Grout Plug Intervals: From 26.8 ft. to 3 ft.

What is the nearest source of possible contamination:

1 Septic tank 6 Seepage pit **11 Fuel Storage** 16 Other
2 Sewer lines 7 Pit privy 12 Fertilizer storage
3 Watertight sewer lines 8 Sewage lagoon 13 Insecticide storage
4 Lateral lines 9 Feedyard 14 Abandoned water well
5 Cess Pool 10 Livestock pens 15 Oil well / Gas well

Direction from well? West How many feet? 15 ft.

FROM	TO	PLUGGING MATERIALS
26.8	3	Bentonite Hole Plug
3	0	Topsoil

Well plugging witnessed by
David Randolph, GMD [illegible]

RECEIVED
SEP 17 2010
Equus Beds Groundwater Management District No. 2

CONTRACTOR'S OR LANDOWNER'S CERTIFICATION: This water well was plugged under my jurisdiction and was completed on (mo/day/year) 7 / 30 / 2010 and this record is true to the best of my knowledge and belief. Kansas Water Well Contractor's License No. NA under the business name of
by (signature) Susan Krehbiel William Susan Krehbiel William, President - Rob Krehbiel Farms, Inc.

INSTRUCTIONS: Use typewriter or ball point pen. Please press firmly and print clearly. Please fill in blanks, and underline or circle the correct answers. Send top three copies to Kansas Department of Health and Environment, Bureau of Water, Topeka, Kansas 66620-0001. Telephone: 913/296-3565. Send one to Water Well Owner and retain one for your records.