

CORRECTION(S) TO WATER WELL RECORD (WWC-5)

(to rectify lacking or incorrect information)

Location listed as:

Section-Township-Range: _____

Fraction ($\frac{1}{4}$ $\frac{1}{4}$ $\frac{1}{4}$): _____

County: Harvey

Location ~~changed to~~

11-245-3W

SE SE SE NE

Other changes: Initial statements: Sedgwick County

Changed to: Harvey County


Comments: _____

verification method: Latitude & longitude, KGS' "LEO" conversion tool,
and mapping tool on KGS website.

initials: DRF date: 3/21/2012

submitted by: Kansas Geological Survey, Data Resources Library, 1930 Constant Ave., Lawrence, KS 66047-3726
to: Kansas Dept of Health & Environment, Bureau of Water, 1000 SW Jackson, Suite 420, Topeka, KS 66612-1367.

1	LOCATION OF WATER WELL:	Fraction	Section	Number	Township	Number	Range	Number																								
	County: SEDGWICK	SE 1/4 SE 1/4 NE 1/4	11		24	5	3	E																								
Distance and direction from nearest town or city street address of well if located within city? 37° 58' 42.9" N 97° 36' 38.55" W																																
2	WATER WELL OWNER: City of Wichita RR #, St. Address, Box #: 6016 S. Spring Lake Rd City, State, ZIP Code: Halstead, KS 67056 Board of Agriculture, Division of Water Resources Application Number:																															
3	MARK WELL'S LOCATION WITH AN "X" IN SECTION BOX:		4 DEPTH OF WELL 259 ft. WELL'S STATIC WATER LEVEL 37 ft. WELL WAS USED AS: <table border="0" style="width:100%"><tr><td>1 Domestic</td><td>☒ 5 Public Water Supply</td><td>9 Dewatering</td></tr><tr><td>2 Irrigation</td><td>6 Oil Field Water Supply</td><td>10 Monitoring Well</td></tr><tr><td>3 Feedlot</td><td>7 Domestic (Lawn & Garden)</td><td>11 Injection Well</td></tr><tr><td>4 Industrial</td><td>8 Air Conditioning</td><td>12 Other</td></tr></table> Was a chemical / bacteriological sample submitted to Department? Yes No ☒ If yes, mo/day/yr sample was submitted Water Well Disinfected: Yes ☒ No						1 Domestic	☒ 5 Public Water Supply	9 Dewatering	2 Irrigation	6 Oil Field Water Supply	10 Monitoring Well	3 Feedlot	7 Domestic (Lawn & Garden)	11 Injection Well	4 Industrial	8 Air Conditioning	12 Other												
1 Domestic	☒ 5 Public Water Supply	9 Dewatering																														
2 Irrigation	6 Oil Field Water Supply	10 Monitoring Well																														
3 Feedlot	7 Domestic (Lawn & Garden)	11 Injection Well																														
4 Industrial	8 Air Conditioning	12 Other																														
N <table border="1" style="width: 100%; text-align: center;"><tr><td>NW</td><td>NE</td></tr><tr><td>W</td><td>X E</td></tr><tr><td>SW</td><td>SE</td></tr><tr><td>S</td><td></td></tr></table> S									NW	NE	W	X E	SW	SE	S																	
NW	NE																															
W	X E																															
SW	SE																															
S																																
5	TYPE OF BLANK CASING USED: <table border="0" style="width:100%"><tr><td>☒ Steel</td><td>3 RMP (SR)</td><td>5 Wrought</td><td>7 Fiberglass</td><td>9 Other (Specify below)</td></tr><tr><td>2 PVC</td><td>4 ABS</td><td>6 Asbestos-Cement</td><td>8 Concrete Tile</td><td></td></tr></table> Blank casing diameter 18 in. Was casing pulled? Yes ☒ No If yes, how much 4' Casing height above or below land surface in.								☒ Steel	3 RMP (SR)	5 Wrought	7 Fiberglass	9 Other (Specify below)	2 PVC	4 ABS	6 Asbestos-Cement	8 Concrete Tile															
☒ Steel	3 RMP (SR)	5 Wrought	7 Fiberglass	9 Other (Specify below)																												
2 PVC	4 ABS	6 Asbestos-Cement	8 Concrete Tile																													
6	GROUT PLUG MATERIAL: 1 Neat cement ☒ 2 Cement grout 3 Bentonite 4 Other Grout Plug Intervals: From 37 ft. to 4 ft., From ft. to ft., From to ft. What is the nearest source of possible contamination: <table border="0" style="width:100%"><tr><td>1 Septic tank</td><td>6 Seepage pit</td><td>11 Fuel storage</td><td>☒ 16 Other (specify below)</td></tr><tr><td>2 Sewer lines</td><td>7 Pit privy</td><td>12 Fertilizer storage</td><td></td></tr><tr><td>3 Watertight sewer lines</td><td>8 Sewage lagoon</td><td>13 Insecticide storage</td><td></td></tr><tr><td>4 Lateral lines</td><td>9 Feedyard</td><td>14 Abandoned water well</td><td>None known</td></tr><tr><td>5 Cess pool</td><td>10 Livestock pens</td><td>15 Oil well/Gas well</td><td></td></tr></table> Direction from well? How many feet?								1 Septic tank	6 Seepage pit	11 Fuel storage	☒ 16 Other (specify below)	2 Sewer lines	7 Pit privy	12 Fertilizer storage		3 Watertight sewer lines	8 Sewage lagoon	13 Insecticide storage		4 Lateral lines	9 Feedyard	14 Abandoned water well	None known	5 Cess pool	10 Livestock pens	15 Oil well/Gas well					
1 Septic tank	6 Seepage pit	11 Fuel storage	☒ 16 Other (specify below)																													
2 Sewer lines	7 Pit privy	12 Fertilizer storage																														
3 Watertight sewer lines	8 Sewage lagoon	13 Insecticide storage																														
4 Lateral lines	9 Feedyard	14 Abandoned water well	None known																													
5 Cess pool	10 Livestock pens	15 Oil well/Gas well																														
<table border="1" style="width:100%"><thead><tr><th>FROM</th><th>TO</th><th>PLUGGING MATERIALS</th></tr></thead><tbody><tr><td>259</td><td>37</td><td>Chlorinated Sand</td></tr><tr><td>37</td><td>4</td><td>Cement Grout</td></tr><tr><td>4</td><td>0</td><td>Native Soil</td></tr><tr><td> </td><td> </td><td> </td></tr><tr><td> </td><td> </td><td> </td></tr><tr><td> </td><td> </td><td> </td></tr><tr><td> </td><td> </td><td> </td></tr></tbody></table>									FROM	TO	PLUGGING MATERIALS	259	37	Chlorinated Sand	37	4	Cement Grout	4	0	Native Soil												
FROM	TO	PLUGGING MATERIALS																														
259	37	Chlorinated Sand																														
37	4	Cement Grout																														
4	0	Native Soil																														
7	CONTRACTOR'S OF LANDOWNER'S CERTIFICATION: This water well was plugged under my jurisdiction and was completed on (mo/day/year) 3/2/05 and this record is true to the best of my knowledge and belief. Kansas Water Well Contractor's License No. This Water Well Record was completed on (mo/day/year) under the business name of LAYNE CHRISTENSEN COMPANY by (signature) CHAD NEMAN PROJECT MANAGER																															
INSTRUCTIONS: Use typewriter or ball point pen. Please press firmly and print clearly. Please fill in blanks, underline or circle the correct answers. Send top three copies to Kansas Department of Health and Environment, Bureau of Water, Geology Section, 1000 SW Jackson St., Ste. 420, Topeka, Kansas 66612-1367. Telephone: 785/296-5522. Send one to Water Well Owner and retain one for your records.																																

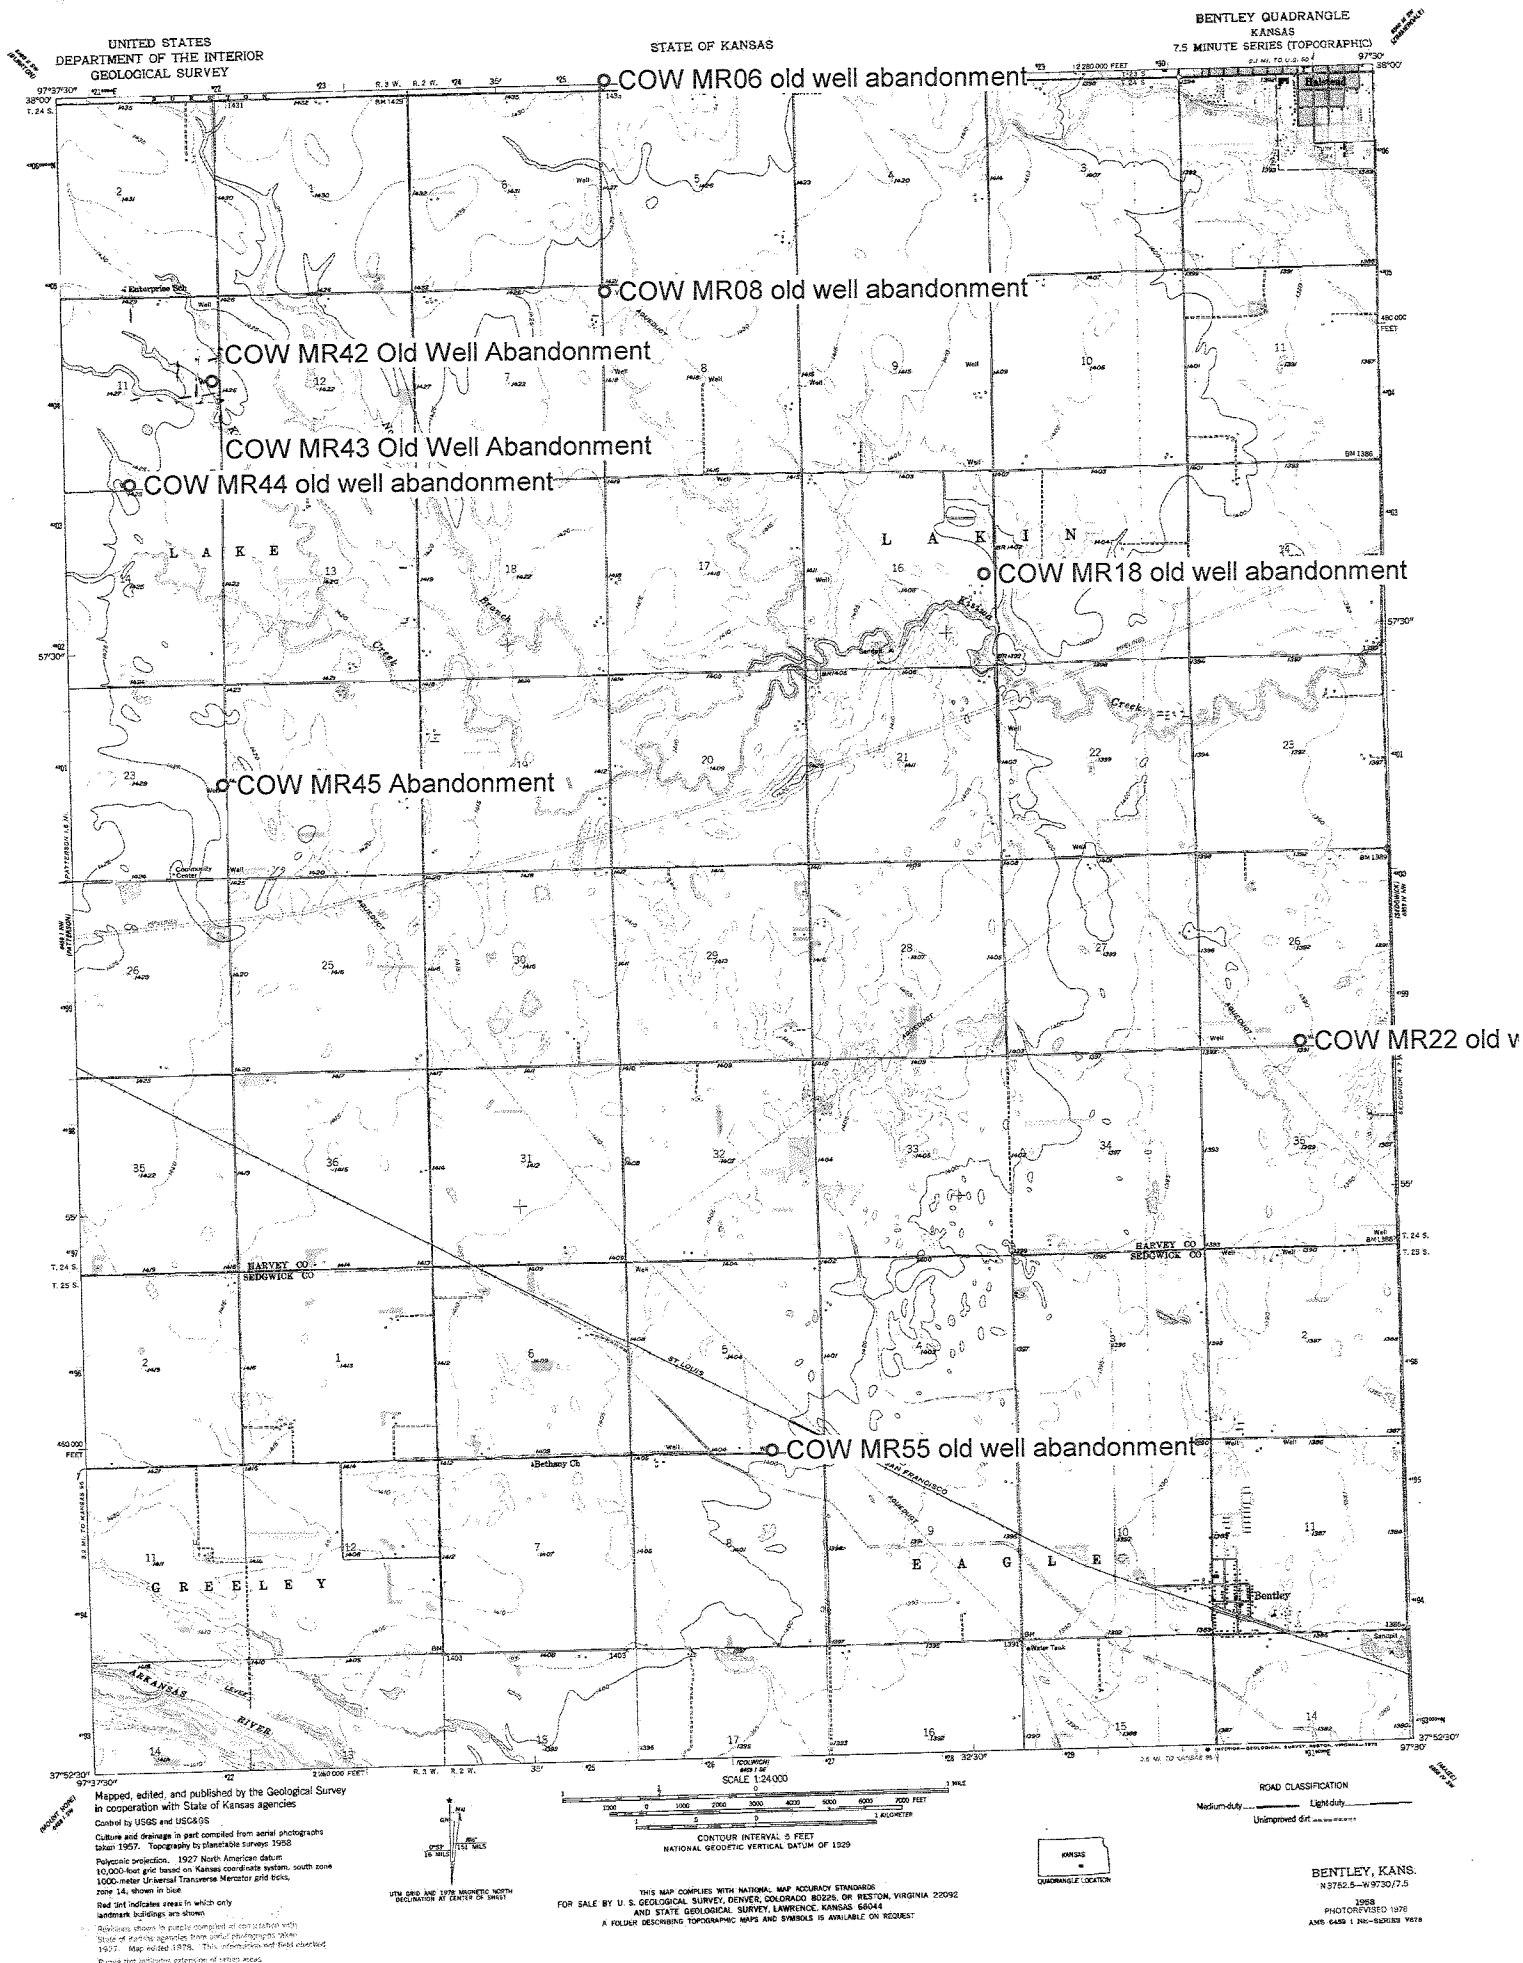

UNITED STATES
DEPARTMENT OF THE INTERIOR
GEOLOGICAL SURVEY

STATE OF KANSAS

BENTLEY QUADRANGLE

KANSAS

7.5 MINUTE SERIES (TOPOGRAPHIC)

U.S. GEOLOGICAL SURVEY

COW MR06 old well abandonment

COW MR08 old well abandonment

COW MR42 Old Well Abandonment

COW MR43 Old Well Abandonment

COW MR44 old well abandonment

COW MR18 old well abandonment

COW MR45 Abandonment

COW MR22 old v

COW MR55 old well abandonment

Maped, edited, and published by the Geological Survey
in cooperation with State of Kansas agencies
Control by USGS and USGARS
Culture and drainage in part compiled from aerial photographs
taken 1957. Topography by planimeter survey 1958
Polyconic projection. 1927 North American datum
10,000-foot grid based on Kansas coordinate system, south zone
1000-meter Universal Transverse Mercator grid ticks,
zone 14, shown in blue
Red tint indicates areas in which only
landmark buildings are shown
Relief shown in purple compiled at consultation with
State of Kansas agencies from aerial photographs taken
1957. Map added 1978. This information not field checked
Purple tint indicates portions of river areas

UTM GRID AND 1978 METRIC NORTH
DECLINATION AT CENTER OF SHEET

THIS MAP COMPLIES WITH NATIONAL MAP ACCURACY STANDARDS
FOR SALE BY U. S. GEOLOGICAL SURVEY, DENVER, COLORADO 80226, OR RESTON, VIRGINIA 22092
AND STATE GEOLOGICAL SURVEY, LAWRENCE, KANSAS 66044
A FOLDER DESCRIBING TOPOGRAPHIC MAPS AND SYMBOLS IS AVAILABLE ON REQUEST

KANSAS
QUADRANGLE LOCATION

BENTLEY, KANS.
N 37° 52' 50" - N 37° 30' 7.5"
PHOTOGRAPHED 1978
AMS 6452 1 INCH-SQUARE FEET