CORRECTION(S) TO WATER WELL RECORD (WWC-5)
(to rectify lacking or incorrect information)

County: Harvey

Location listed as:

Section-Township-Range: _____

Fraction (¼ ¼ ¼): _____

Location ~~changed to~~:

11 - 24S - 3W

SE SE SE SE

Other changes: Initial statements: Sedgwick County

Changed to: Harvey County

Comments: _____

verification method: Latitude & longitude, KGS' "LEO" conversion tool, and mapping tool on KGS website.

initials: DRL date: 3/21/2012

submitted by: Kansas Geological Survey, Data Resources Library, 1930 Constant Ave., Lawrence, KS 66047-3726
to: Kansas Dept of Health & Environment, Bureau of Water, 1000 SW Jackson, Suite 420, Topeka, KS 66612-1367.

WATER WELL PLUGGING RECORD Form WWC-5P KSA 82a-1212 ID NO. MR 43

1 LOCATION OF WATER WELL:	Fraction	Section Number	Township Number	Range Number
County: SEDGWICK	SE¼ SE¼ SE¼	11	24 S	3 E/W

Distance and direction from nearest town or city street address of well if located within city? Approx. N 37.97144 W 97.61083

2 WATER WELL OWNER: City of Wichita
RR #, St. Address, Box #: 6016 S. Spring Lake Rd
City, State, ZIP Code : Halstead, KS 67056

Board of Agriculture, Division of Water Resources Application Number:

3 MARK WELL'S LOCATION WITH AN "X" IN SECTION BOX:

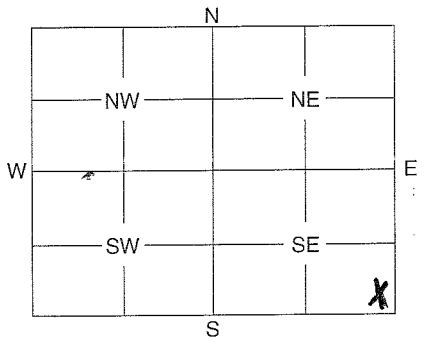

4 DEPTH OF WELL 121 ft.

WELL'S STATIC WATER LEVEL 14.3 ft.

WELL WAS USED AS:

1 Domestic 2 Irrigation 3 Feedlot 4 Industrial 5 Public Water Supply 6 Oil Field Water Supply 7 Domestic (Lawn & Garden) 8 Air Conditioning 9 Dewatering 10 Monitoring Well 11 Injection Well 12 Other

Was a chemical / bacteriological sample submitted to Department? Yes ..... No X
If yes, mo/day/yr sample was submitted .....

Water Well Disinfected: Yes X No .....

5 TYPE OF BLANK CASING USED:

1 Steel 2 PVC 3 RMP (SR) 4 ABS 5 Wrought 6 Asbestos-Cement 7 Fiberglass 8 Concrete Tile 9 Other (Specify below) .....

Blank casing diameter 18 in. Was casing pulled? Yes X No ..... If yes, how much 4'
Casing height above or below land surface .... in.

6 GROUT PLUG MATERIAL: 1 Neat cement 2 Cement grout 3 Bentonite 4 Other .....

Grout Plug Intervals: From 24 ft. to 4 ft., From ..... ft. to ..... ft., From ..... to ..... ft.

What is the nearest source of possible contamination:

1 Septic tank 2 Sewer lines 3 Watertight sewer lines 4 Lateral lines 5 Cess pool 6 Seepage pit 7 Pit privy 8 Sewage lagoon 9 Feedyard 10 Livestock pens 11 Fuel storage 12 Fertilizer storage 13 Insecticide storage 14 Abandoned water well 15 Oil well/Gas well 16 Other (specify below) .....

None Known

Direction from well? ..... How many feet? .....

FROM	TO	PLUGGING MATERIALS
121	24	Chlorinated Sand
24	4	Cement Grout
4	0	Native Soil

7 CONTRACTOR'S OF LANDOWNER'S CERTIFICATION: This water well was plugged under my jurisdiction and was completed on (mo/day/year) 9/1/21 and this record is true to the best of my knowledge and belief. Kansas Water Well Contractor's License No. 102 This Water Well Record was completed on (mo/day/year) ..... under the business name of LAYNE CHRISTENSEN COMPANY by (signature) ..... CHAD ISEMAN PROJECT MANAGER

INSTRUCTIONS: Use typewriter or ball point pen. Please press firmly and print clearly. Please fill in blanks, underline or circle the correct answers. Send top three copies to Kansas Department of Health and Environment, Bureau of Water, Geology Section, 1000 SW Jackson St., Ste. 420, Topeka, Kansas 66612-1367. Telephone: 785/296-5522. Send one to Water Well Owner and retain one for your records.

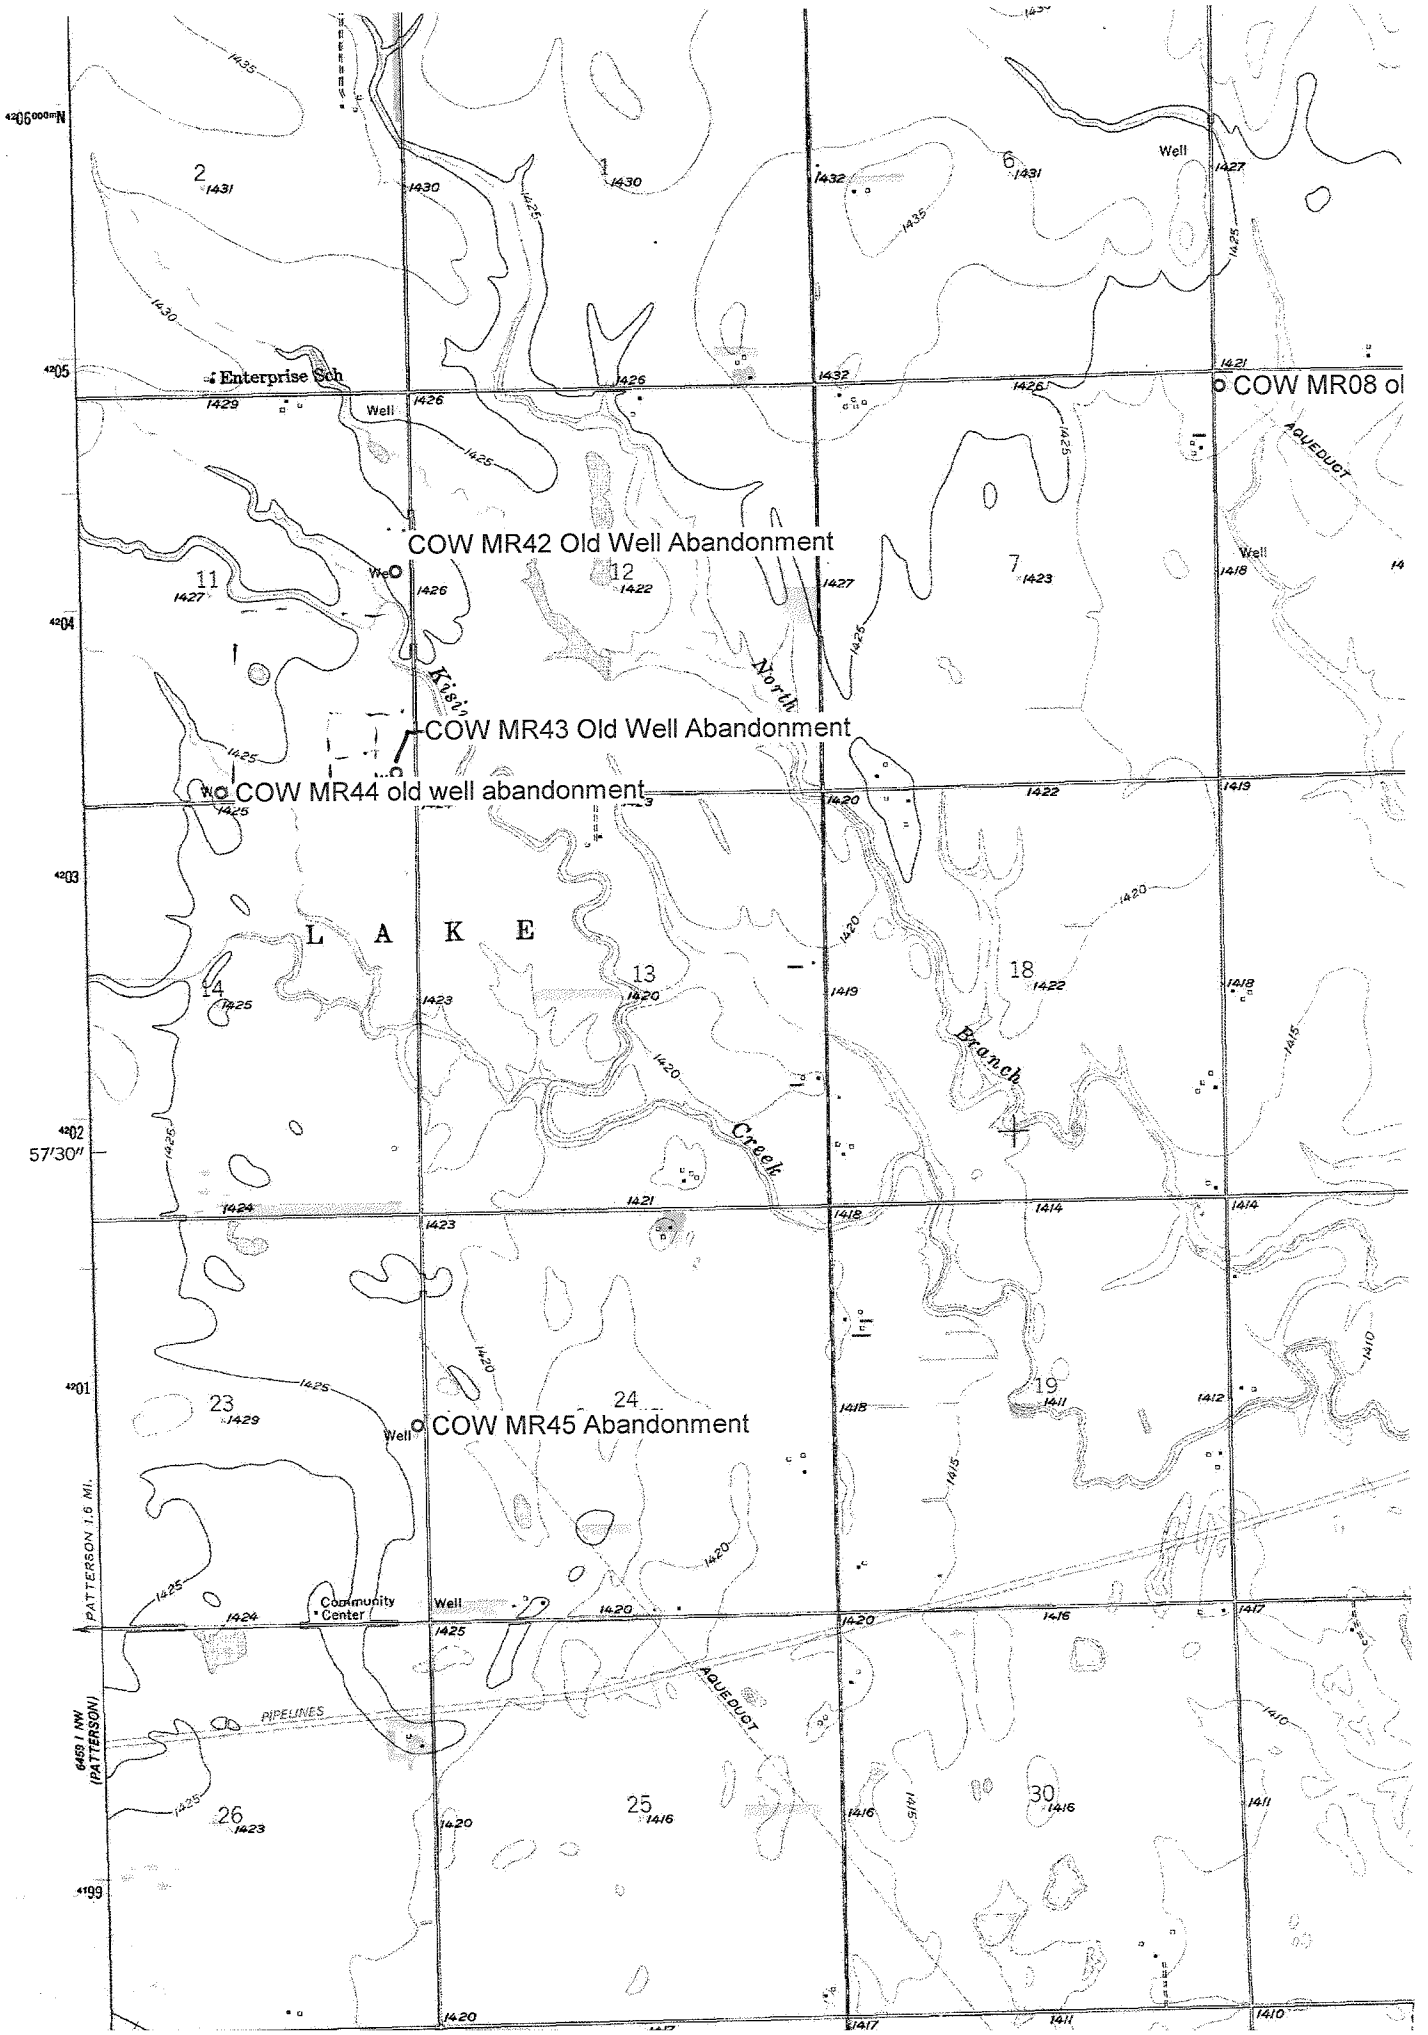
COW MR42 Old Well Abandonment
COW MR43 Old Well Abandonment
COW MR44 old well abandonment
COW MR45 Abandonment
COW MR08 ol
L A K E
Enterprise Sch
Community Center
PATTERSON 1.6 MI.
6459 I NW (PATTERSON)
PIPELINES
AQUEDUCT
North Branch Creek
Well
4206 000mN
57'30"