WATER WELL PLUGGING RECORD Form WWC-5P KSA 82a-1212 ID NO. 32954

1 LOCATION OF WATER WELL: County: Harvey	Fraction: ¼ NE ¼ SW ¼ NW ¼	Section Number: 21	Township Number: T 24 S	Range Number: 3 ☐ E ☑ W

Street/Rural Address of Well Location; if unknown, distance & direction from nearest town or intersection: If at owner's address, check here ☐ approximately 4.75 miles south and 0.25 miles east of Burrton, KS

Global Positioning Systems (GPS) information:
Latitude: 37.95235 (in decimal degrees)
Longitude: -97.66080 (in decimal degrees)
Elevation:
Horizontal Datum: ☐ WGS84, ☐ NAD83, ☑ NAD27
Collection Method:
☑ GPS unit (Make/Model: Garmin GPSmap 60CSx
☐ Digital Map/Photo, ☐ Topographic Map, ☐ Land Survey
Est. Accuracy: ☐ < 3 m, ☑ 3-5 m, ☐ 5-15 m, ☐ > 15 m

2 WATER WELL OWNER: Pennington KS FRM LLC Etal
RR#, St. Address, Box #: 48120 NW Hillside Rd
City, State ZIP Code: Forest Grove, OR 97116

3 MARK WELL'S LOCATION WITH AN "X" IN SECTION BOX:

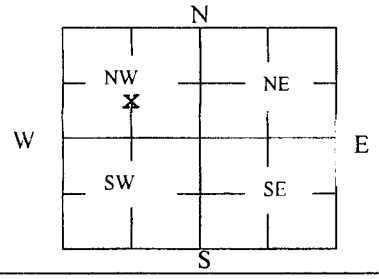

4 DEPTH OF WELL 65 ft.
WELL'S STATIC WATER LEVEL 7 ft
WELL WAS USED AS:

☐ Domestic	☐ Public Water Supply	☐ Dewatering	
☑ Irrigation	☐ Oil Field Water Supply	☐ Monitoring	
☐ Feedlot	☐ Domestic (Lawn & Garden)	☐ Injection Well	
☐ Industrial	☐ Air Conditioning	☐ Other	

Was a chemical/bacteriological sample submitted to Department? Yes ☐ No ☑

5 TYPE OF BLANK CASING USED:

☐ Steel	☐ RMP (SR)	☐ Wrought	☐ Fiberglass	☐ Other (Specify below)
☐ PVC	☐ ABS	☑ Asbestos-Cement	☐ Concrete Tile	

Blank casing diameter 16 in. Was casing pulled? Yes ☐ No ☑ If yes, how much
Casing height above or below land surface below 36 in.

6 GROUT PLUG MATERIAL: ☐ Neat cement ☐ Cement grout ☑ Bentonite ☐ Other

Grout Plug Intervals: From 10 ft. to 3 ft., From ft. to ft., From ft. to ft.

What is the nearest source of possible contamination:

☐ Septic tank	☐ Seepage pit	☐ Fuel storage	☑ Other (specify below) None within 1/4 mile.
☐ Sewer lines	☐ Pit privy	☐ Fertilizer storage	
☐ Watertight sewer lines	☐ Sewage lagoon	☐ Insecticide storage	
☐ Lateral lines	☐ Feedyard	☐ Abandoned water well	Direction from well?
☐ Cess pool	☐ Livestock pens	☐ Oil well/Gas well	How many feet?

FROM	TO	PLUGGING MATERIALS	FROM	TO	PLUGGING MATERIALS
65	10	Clean, course sand			Well plugging witnessed by
10	3	Bentonite Hole Plug			D. Randolph, GMD2 staff,
3	0	Topsoil			on 11/4/2016.

7 CONTRACTOR'S OR LANDOWNER'S CERTIFICATION: This water well was plugged under my jurisdiction and was completed on (mo/day/year) 11/4/2016 and this record is true to the best of my knowledge and belief. Kansas Water Well Contractor's License No. . This Water Well Record was completed on (mo/day/year) 11/8/2016 under the business name of by (signature)

RECEIVED
FEB 27 2017
Equus Beds Groundwater Management District No. 2

Send one white copy to Kansas Department of Health & Environment, Geology Section, 1000 SW Jackson Street, Ste. 420, Topeka, KS 66612-1367. Send one copy to WATER WELL OWNER and retain one for your records.
Visit us at http://www.kdheks.gov/waterwell/index.html Telephone 785-296-5524.