

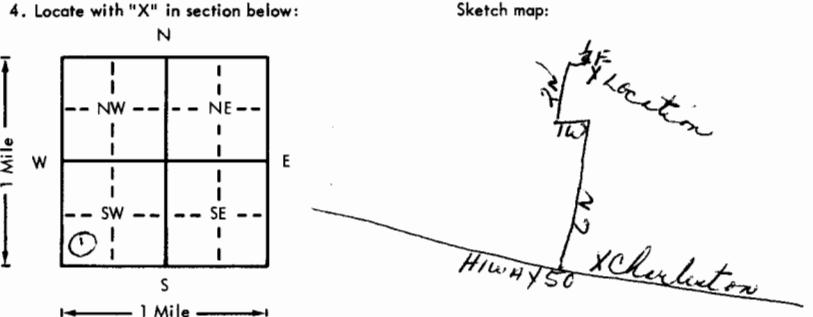
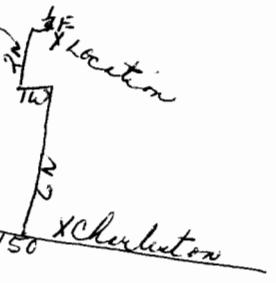
USE TYPEWRITER OR BALL
POINT PEN-PRESS FIRMLY,
PRINT CLEARLY.

WATER WELL RECORD
KSA 82a-1201-1215

Kansas Department of Health and
Environment-Division of Environment
(Water well Contractors)
Topeka, Kansas 66620

Werner #1 Inv. # 12136

Inv. # 12136

1. Location of well:	County Gray	Fraction C 1/4 SW 1/4 SW 1/4	Section number 2	Township number T 24	Range number S R 30
2. Distance and direction from nearest town or city: 6 north, 1 west, 2 north, $\frac{1}{4}$ east.	3. Owner of well: Rains & Williamson Oil Co., Inc.				
Street address of well location if in city: 435 Page Court, 220 West Douglas	City, state, zip code: Wichita, Kansas 67202				
4. Locate with "X" in section below: 			Sketch map: 		
5. Type and color of material			From	To	6. Bore hole dia. <u>9</u> in. Completion date <u>3-15</u> Well depth <u>220</u> ft.
Surface			0	2	7. <input type="checkbox"/> Cable tool <input checked="" type="checkbox"/> Rotary <input type="checkbox"/> Driven <input type="checkbox"/> Dug <input type="checkbox"/> Hollow rod <input type="checkbox"/> Jetted <input type="checkbox"/> Bored <input type="checkbox"/> Reverse rotary
Sandy clay			2	30	8. Use: <input type="checkbox"/> Domestic <input type="checkbox"/> Public supply <input type="checkbox"/> Industry <input type="checkbox"/> Irrigation <input type="checkbox"/> Air conditioning <input type="checkbox"/> Stock <input type="checkbox"/> Lawn <input checked="" type="checkbox"/> Oil field water <input type="checkbox"/> Other
Fine to medium sand			30	120	9. Casing: Material <input checked="" type="checkbox"/> PVC <input type="checkbox"/> Height: Above or below Threaded <input type="checkbox"/> Welded <input type="checkbox"/> Surface <u>28</u> in. RMP <input type="checkbox"/> PVC <input checked="" type="checkbox"/> Weight <u>2.78</u> lbs./ft. Dia. <u>5</u> in. to <u>110</u> ft. depth Wall thickness: inches or Dia. <u>5</u> in. to <u>220</u> ft. depth gage No. <u>265</u>
Fine to medium sand & sandy clay 60-40			120	130	10. Screen: Manufacturer's name <input type="checkbox"/> sawed perf.
Medium to large sand & sandy clay 70-30			130	140	Type <input checked="" type="checkbox"/> PVC <input type="checkbox"/> Dia. <u>5"</u> Slot/gauze <u>.030</u> <input type="checkbox"/> Length <u>100</u> Set between <u>110</u> ft. and <u>210</u> ft. ft. and <u>210</u> ft. Gravel pack? <input type="checkbox"/> yes Size range of material <u>1/8</u> to <u>1/4</u>
Medium to large sand & firm sandy clay 70-20			140	175	11. Static water level: <u>113</u> ft. below land surface Date <u>3-15-76</u>
Medium to large sand w/rock & blue sandy clay			175	180	12. Pumping level below land surfaces: <u>100</u> ft. after <u>hrs.</u> pumping <u>g.p.m.</u> <u>100</u> ft. after <u>hrs.</u> pumping <u>g.p.m.</u> Estimated maximum yield <u>50</u> g.p.m.
Blue clay			180	220	13. Water sample submitted: <input type="checkbox"/> Yes <input checked="" type="checkbox"/> No Date <u>mo./day/yr.</u>
(Use a second sheet if needed)					14. Well head completion: <input type="checkbox"/> Pitless adapter <u>28</u> Inches above grade
18. Elevation:			19. Remarks: Topography: <input type="checkbox"/> Hill <input type="checkbox"/> Slope <input checked="" type="checkbox"/> Upland <input type="checkbox"/> Valley		
20. Water well contractor's certification: This well was drilled under my jurisdiction and this report is true to the best of my knowledge and belief. Carlile Water Well 118			Business name <u>Box 275, Liberal, KS.</u> License No. Address <u>Box 275, Liberal, KS.</u> Signed <u>Edward E. Means</u> Date <u>4-1-19</u> Authorized representative		