


1 LOCATION OF WATER WELL:	Fraction	Section Number	Township Number	Range Number
County: <b>Gray</b>	<b>SE 1/4 SE 1/4 SW 1/4</b>	<b>13</b>	<b>T 24 S</b>	<b>R 30 E</b>

Distance and direction from nearest town or city street address of well if located within city?

From Charleston east side 6 1/2 miles North 1/2 mile west.

2 WATER WELL OWNER:	<b>Agnes H. Miller</b>	Board of Agriculture, Division of Water Resources
RR#, St. Address, Box #:	<b>RR 1</b>	Application Number:
City, State, ZIP Code:	<b>Tyrells, KS 67853</b>	

3 LOCATE WELL'S LOCATION WITH AN "X" IN SECTION BOX:	4 DEPTH OF COMPLETED WELL:	ft. ELEVATION:
--	----------------------------	----------------

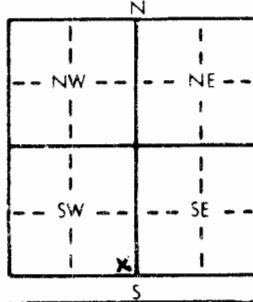

Depth(s) Groundwater Encountered 1. ft. 2. ft. 3. ft.

WELL'S STATIC WATER LEVEL **979.00** ft. below land surface measured on mo/day/yr

Pump test data: Well water was ft. after hours pumping gpm

Est. Yield gpm: Well water was ft. after hours pumping gpm

Bore Hole Diameter **N/A** in. to ft. and in. to ft.

WELL WATER TO BE USED AS: 5 Public water supply 8 Air conditioning 11 Injection well

<b>1 Domestic</b>	3 Feedlot	6 Oil field water supply	9 Dewatering	12 Other (Specify below)
<b>2 Irrigation</b>	4 Industrial	7 Lawn and garden only	10 Monitoring well	

Was a chemical/bacteriological sample submitted to Department? Yes.....No..... If yes, mo/day/yr sample was submitted

Water Well Disinfected? Yes No

5 TYPE OF BLANK CASING USED:	5 Wrought iron	8 Concrete tile	CASING JOINTS: Glued	Clamped
------------------------------	----------------	-----------------	----------------------	---------

1 Steel 3 RMP (SR) 6 Asbestos-Cement 9 Other (specify below) Welded

2 PVC 4 ABS 7 Fiberglass **Galvanized** Threaded

Blank casing diameter **5"** in. to ft. Dia in. to ft. Dia in. to ft.

Casing height above land surface **36** in. weight lbs/ft. Wall thickness or gauge No.

TYPE OF SCREEN OR PERFORATION MATERIAL:	7 PVC	10 Asbestos-cement
---	-------	--------------------

1 Steel 3 Stainless steel 5 Fiberglass 8 RMP (SR) 11 Other (specify) **N/A**

2 Brass 4 Galvanized steel 6 Concrete tile 9 ABS 12 None used (open hole)

SCREEN OR PERFORATION OPENINGS ARE:	5 Gauzed wrapped	8 Saw cut	11 None (open hole)
-------------------------------------	------------------	-----------	---------------------

1 Continuous slot 3 Mill slot 6 Wire wrapped 9 Drilled holes

2 Louvered shutter 4 Key punched 7 Torch cut 10 Other (specify) **N/A**

SCREEN-PERFORATED INTERVALS: From	<b>N/A</b>	ft. to <b>N/A</b>	ft. From	ft. to ft.
-----------------------------------	------------	-------------------	----------	------------

From ft. to ft. From ft. to ft. From ft. to ft. From ft. to ft.

GRAVEL PACK INTERVALS: From	ft. to	ft. From	ft. to
-----------------------------	--------	----------	--------

From ft. to ft. From ft. to ft. From ft. to ft. From ft. to ft.

6 GROUT MATERIAL: 1 Neat cement	2 Cement grout	3 Bentonite	4 Other
---------------------------------	----------------	-------------	---------

Grout Intervals: From **3** ft. to **121** ft. From ft. to ft. From ft. to ft.

What is the nearest source of possible contamination:

1 Septic tank 4 Lateral lines 7 Pit privy 10 Livestock pens 14 Abandoned water well

2 Sewer lines 5 Cess pool 8 Sewage lagoon 11 Fuel storage 15 Oil well/Gas well

3 Watertight sewer lines 6 Seepage pit 9 Feedyard 12 Fertilizer storage 16 Other (specify below)

13 Insecticide storage

How many feet?

FROM	TO	LITHOLOGIC LOG	FROM	TO	PLUGGING INTERVALS
------	----	----------------	------	----	--------------------

**3'** **121'** **Bentonite chips**  
**2x2 Cement Cap**

7 CONTRACTOR'S OR LANDOWNER'S CERTIFICATION: This water well was (1) constructed, (2) reconstructed, or (3) plugged under my jurisdiction and was completed on (mo/day/year) <b>4-14-94</b> and this record is true to the best of my knowledge and belief. Kansas
--

Water Well Contractor's License No. **S33** This Water Well Record was completed on (mo/day/yr) **4-26-94**

under the business name of **Jantzen Water Well Repair** by (signature)