

County: Finney Fraction: NW NW NW Sec. 18 T. 24 S R. 32 W

CORRECTION(S) to WATER WELL COMPLETION RECORD Form WWC-5 (to rectify lacking or incorrect information)

Owner: 5 points 66 PMW 1

If location corrected, was listed as:

Section-Township-Range: 18-24-33W

Location changed to:

18-24-32W

Fraction (1/4 calls): _____

Other changes: Initial statements: _____

Changed to: _____

Comments: _____

Verification method: owner address on WWC5, address in Newspaper and directions verified by KGS

Interactive Map and Google maps

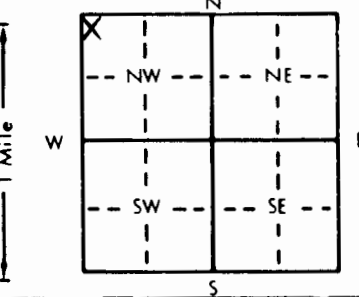
Initials: SH Date: 08-26-2019

Submitted by: Kansas Geological Survey, Data Resources Library, 1930 Constant Ave., Lawrence, KS 66047-3724
 Kansas Dept. of Health & Environment, Bureau of Water, 1000 SW Jackson, Suite 420, Topeka, KS 66612-1367

1] LOCATION OF WATER WELL: Fraction **NW NW 1/4 NW** Section Number **18** Township Number **T 24 S** Range Number **R 33 E** **(W)**
 County: **Finney**
 Distance and direction from nearest town or city street address of well if located within city?

Northwest corner of 13th Street and Buffalo Jones Avenue

2] WATER WELL OWNER: **5 Points 66**
 RR#, St. Address, Box #: **705 Buffalo Jones**
 City, State, ZIP Code: **Garden City, KS.**
 Board of Agriculture, Division of Water Resources
 Application Number:

3] LOCATE WELL'S LOCATION WITH AN "X" IN SECTION BOX:

 4] DEPTH OF COMPLETED WELL: **33** ft. ELEVATION: **NA**
 Depth(s) Groundwater Encountered 1. **23** ft. 2. _____ ft. 3. _____ ft.
 WELL'S STATIC WATER LEVEL: **23.25** ft. below land surface measured on mo/day/yr **11-11-93**
 Pump test data: Well water was _____ ft. after _____ hours pumping _____ gpm
 Est. Yield _____ gpm: Well water was _____ ft. after _____ hours pumping _____ gpm
 Bore Hole Diameter: **7 5/8** in. to **33** ft. and _____ in. to _____ ft.
 WELL WATER TO BE USED AS:
 5 Public water supply 8 Air conditioning 11 Injection well
 1 Domestic 3 Feedlot 6 Oil field water supply 9 Dewatering 12 Other (Specify below)
 2 Irrigation 4 Industrial 7 Lawn and garden only **10** Monitoring well
 Was a chemical/bacteriological sample submitted to Department? Yes _____ No **x**; If yes, mo/day/yr sample was submitted
 Water Well Disinfected? Yes _____ No **x**

5] TYPE OF BLANK CASING USED:
 1 Steel 3 RMP (SR) 5 Wrought iron 8 Concrete tile CASING JOINTS: Glued _____ Clamped _____
2 PVC 4 ABS 6 Asbestos-Cement 9 Other (specify below) Welded _____
 7 Fiberglass Threaded **x**
 Blank casing diameter **2** in. to **18** ft. Dia _____ in. to _____ ft. Dia _____ in. to _____ ft.
 Casing height above land surface **0** in. weight _____ lbs./ft. Wall thickness or gauge No. **sch. 40**
 TYPE OF SCREEN OR PERFORATION MATERIAL:
 1 Steel 3 Stainless steel 5 Fiberglass **7** PVC 10 Asbestos-cement
 2 Brass 4 Galvanized steel 6 Concrete tile 8 RMP (SR) 11 Other (specify) _____
 9 ABS 12 None used (open hole)
 SCREEN OR PERFORATION OPENINGS ARE:
 1 Continuous slot **3** Mill slot 5 Gauzed wrapped 8 Saw cut 11 None (open hole)
 2 Louvered shutter 4 Key punched 6 Wire wrapped 9 Drilled holes
 7 Torch cut 10 Other (specify) _____
 SCREEN-PERFORATED INTERVALS: From **18** ft. to **33** ft. From _____ ft. to _____ ft.
 From _____ ft. to _____ ft. From _____ ft. to _____ ft.
 GRAVEL PACK INTERVALS: From **16** ft. to **33** ft. From _____ ft. to _____ ft.
 From _____ ft. to _____ ft. From _____ ft. to _____ ft.

6] GROUT MATERIAL: 1 Neat cement **2** Cement grout **3** Bentonite 4 Other _____
 Grout Intervals: From **0** ft. to **14** ft. From **14** ft. to **16** ft. From _____ ft. to _____ ft.
 What is the nearest source of possible contamination:
 1 Septic tank 4 Lateral lines 7 Pit privy **11** Fuel storage 10 Livestock pens 14 Abandoned water well
 2 Sewer lines 5 Cess pool 8 Sewage lagoon 12 Fertilizer storage 15 Oil well/Gas well
 3 Watertight sewer lines 6 Seepage pit 9 Feedyard 13 Insecticide storage 16 Other (specify below) _____

Direction from well? **northwest** How many feet? **280**

FROM	TO	LITHOLOGIC LOG	FROM	TO	PLUGGING INTERVALS
0	1	cl. med brn, v slty, v sndy, f-med grnd			
1	6	cl. lt brn, v slty, v sndy, f-med grnd			
6	8	cl. med brn, w/tint of gry, sl sndy, v f-med, v slty			
8	10	snd, orag-yell, v f-f grnd, rnd-subang			
10	15	snd, v -c grnd, sl rock up to 1/2", sl grvl, yell-brn color			
15	20	snd, v-c grnd, tr of rock & grvl, yell-brn color			
20	30	snd, v f-c grnd, mod grvl, prly srtcd			
30	33	snd, v f-c grnd, sl grvl, prly srtcd, sl rock up to 2" in size			PMW1-flush mount cover

7] CONTRACTOR'S OR LANDOWNER'S CERTIFICATION: This water well was **(1)** constructed, (2) reconstructed, or (3) plugged under my jurisdiction and was completed on (mo/day/year) **11-07-93** and this record is true to the best of my knowledge and belief. Kansas Water Well Contractor's License No. **527** This Water Well Record was completed on (mo/day/yr) _____ under the business name of **GeoCore Services, Inc.** by (signature) *Dale O. Kell* **12-15-93**

INSTRUCTIONS: Use typewriter or ball point pen. PLEASE PRESS FIRMLY and PRINT clearly. Please fill in blanks, underline or circle the correct answers. Send top three copies to Kansas Department of Health and Environment, Bureau of Water, Topeka, Kansas 66620-0001. Telephone: 913-296-5545. Send one to WATER WELL OWNER and retain one for your records.