

County: Finney Fraction: NW NW NW Sec. 18 T. 24 S R. 32 W

**CORRECTION(S) to WATER WELL COMPLETION RECORD Form WWC-5 (to rectify lacking or incorrect information)**

Owner: 5 points 66 PMW 3

**If location corrected, was listed as:**

Section-Township-Range: 18-24-33W

**Location changed to:**

18-24-32W

Fraction (1/4 calls): \_\_\_\_\_

**Other changes:** Initial statements: \_\_\_\_\_

Changed to: \_\_\_\_\_

Comments: \_\_\_\_\_

Verification method: owner address on WWC5, address in Newspaper and directions verified by KGS

**Interactive Map and Google maps**

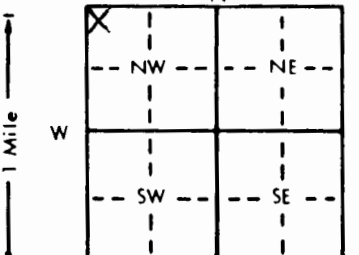
Initials: SH Date: 08-26-2019

Submitted by:  Kansas Geological Survey, Data Resources Library, 1930 Constant Ave., Lawrence, KS 66047-3724  
 Kansas Dept. of Health & Environment, Bureau of Water, 1000 SW Jackson, Suite 420, Topeka, KS 66612-1367

1 LOCATION OF WATER WELL: Fraction **NW<sub>4</sub> NW ¼ NW<sub>¼</sub>** Section Number **18** Township Number **24** Range Number **33**  
 County: **Finney** Board of Agriculture, Division of Water Resources  
 Distance and direction from nearest town or city street address of well if located within city?

**Southeast corner of Buffalo Jones Avenue and Kansas Avenue**

2 WATER WELL OWNER: **5 Points 66**  
 RR#, St. Address, Box #: **705 Buffalo Jones**  
 City, State, ZIP Code: **Garden City, KS.** Application Number: **NA**

3 LOCATE WELL'S LOCATION WITH AN "X" IN SECTION BOX:  4 DEPTH OF COMPLETED WELL: **33** ft. ELEVATION: **NA**  
 Depth(s) Groundwater Encountered 1. **23** ft. 2. . . . . ft. 3. . . . . ft.  
 WELL'S STATIC WATER LEVEL: **23.36** ft. below land surface measured on mo/day/yr **11-11-93**  
 Pump test data: Well water was . . . . . ft. after . . . . . hours pumping . . . . . gpm  
 Est. Yield . . . . . gpm: Well water was . . . . . ft. after . . . . . hours pumping . . . . . gpm  
 Bore Hole Diameter: **7.5/8** in. to **33** ft., and . . . . . in. to . . . . . ft.  
 WELL WATER TO BE USED AS: 5 Public water supply 8 Air conditioning 11 Injection well  
 1 Domestic 3 Feedlot 6 Oil field water supply 9 Dewatering 12 Other (Specify below)  
 2 Irrigation 4 Industrial 7 Lawn and garden only **10** Monitoring well . . . . .  
 Was a chemical/bacteriological sample submitted to Department? Yes . . . . . No **X**; If yes, mo/day/yr sample was submitted

5 TYPE OF BLANK CASING USED: 5 Wrought iron 8 Concrete tile CASING JOINTS: Glued . . . . . Clamped . . . . .  
 1 Steel 3 RMP (SR) 6 Asbestos-Cement 9 Other (specify below) Welded . . . . .  
**2** PVC 4 ABS 7 Fiberglass . . . . . Threaded **X**  
 Blank casing diameter **2** in. to **18** ft., Dia . . . . . in. to . . . . . ft., Dia . . . . . in. to . . . . . ft.  
 Casing height above land surface: **0** in., weight . . . . . lbs./ft. Wall thickness or gauge No. **sch. 40**  
 TYPE OF SCREEN OR PERFORATION MATERIAL: **7** PVC 10 Asbestos-cement  
 1 Steel 3 Stainless steel 5 Fiberglass 8 RMP (SR) 11 Other (specify) . . . . .  
 2 Brass 4 Galvanized steel 6 Concrete tile 9 ABS 12 None used (open hole)  
 SCREEN OR PERFORATION OPENINGS ARE: 5 Gauzed wrapped 8 Saw cut 11 None (open hole)  
 1 Continuous slot **3** Mill slot 6 Wire wrapped 9 Drilled holes  
 2 Louvered shutter 4 Key punched 7 Torch cut 10 Other (specify) . . . . .  
 SCREEN-PERFORATED INTERVALS: From **18** ft. to **33** ft., From . . . . . ft. to . . . . . ft.  
 GRAVEL PACK INTERVALS: From **16** ft. to **33** ft., From . . . . . ft. to . . . . . ft.

6 GROUT MATERIAL: 1 Neat cement **2** Cement grout **3** Bentonite 4 Other . . . . .  
 Grout Intervals: From **0** ft. to **14** ft., From **14** ft. to **16** ft., From . . . . . ft. to . . . . . ft.  
 What is the nearest source of possible contamination:  
 1 Septic tank 4 Lateral lines 7 Pit privy **11** Fuel storage 14 Abandoned water well  
 2 Sewer lines 5 Cess pool 8 Sewage lagoon 12 Fertilizer storage 15 Oil well/Gas well  
 3 Watertight sewer lines 6 Seepage pit 9 Feedyard 13 Insecticide storage 16 Other (specify below)  
 Direction from well? **northwest** How many feet? **110**

FROM	TO	LITHOLOGIC LOG	FROM	TO	PLUGGING INTERVALS
0	4'	cl, red brn, mod slty, tr f-med snd			
4'	6'	cl, lt-med gry, mod slty			
6	8	snd, lt gry, v f grnd, v slty, sl clayey			
8	11	snd, yell brn, v f grnd, v slty, sl clayey			
11	15	snd, v f-c grnd, tr rock, sl grvl, lt gry			
15	20	snd, v f-c grnd, tr rock, mod-v grvly, lt gry			
20	22	snd, v f-f grnd, lt gry color			
22	30	snd, f-c grnd, mod-v grvly, tr of rock, v dk gry			
30	33	snd, f-c grnd, mod-v grvly, mod rock up to 1" in size			
					PMW3-flush mount cover

CONTRACTOR'S OR LANDOWNER'S CERTIFICATION: This water well was **1** constructed, (2) reconstructed, or (3) plugged under my jurisdiction and was completed on (mo/day/year) **11-07-93** and this record is true to the best of my knowledge and belief. Kansas Water Well Contractor's License No. **527** This Water Well Record was completed on (mo/day/yr) **12-15-93**  
 under the business name of **GeoCore Services, Inc.** by (signature) *Del Giff*

INSTRUCTIONS: Use typewriter or ball point pen. PLEASE PRESS FIRMLY and PRINT clearly. Please fill in blanks, underline or circle the correct answers. Send top three copies to Kansas Department of Health and Environment, Bureau of Water, Topeka, Kansas 66620-0001. Telephone: 913-296-5545. Send one to WATER WELL OWNER and retain one for your records.