

County: Finney Fraction: NW NW NW Sec. 18 T. 24 S R. 32 W

CORRECTION(S) to WATER WELL COMPLETION RECORD Form WWC-5 (to rectify lacking or incorrect information)

Owner: 5 points 66 PMW 4

If location corrected, was listed as:

Section-Township-Range: 18-24-33W

Location changed to:

18-24-32W

Fraction (1/4 calls): _____

Other changes: Initial statements: _____

Changed to: _____

Comments: _____

Verification method: owner address on WWC5, address in Newspaper and directions verified by KGS

Interactive Map and Google maps

Initials: SH Date: 08-26-2019


Submitted by: Kansas Geological Survey, Data Resources Library, 1930 Constant Ave., Lawrence, KS 66047-3724
 Kansas Dept. of Health & Environment, Bureau of Water, 1000 SW Jackson, Suite 420, Topeka, KS 66612-1367

1] LOCATION OF WATER WELL: Fraction **NW NW 1/4 NW** Section Number **18** Township Number **T 24 S** Range Number **R 33 EW**
 County: **Finney**
 Distance and direction from nearest town or city street address of well if located within city?

Northwest corner of Kansas Avenue and 13th Street

2] WATER WELL OWNER: **5 Points 66**
705 Buffalo Jones Board of Agriculture, Division of Water Resources
Garden City, KS. Application Number:

3] LOCATE WELL'S LOCATION WITH AN "X" IN SECTION BOX:

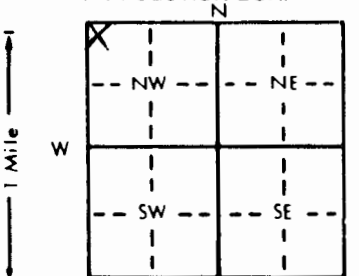

4] DEPTH OF COMPLETED WELL: **33** ft. ELEVATION: **NA**
 Depth(s) Groundwater Encountered 1. **23** ft. 2. ft. 3. ft.
 WELL'S STATIC WATER LEVEL: **23.34** ft. below land surface measured on mo/day/yr **11-11-93**
 Pump test data: Well water was ft. after hours pumping gpm
 Est. Yield gpm: Well water was ft. after hours pumping gpm
 Bore Hole Diameter: **7 5/8** in. to **33** ft. and in. to ft.
 WELL WATER TO BE USED AS:
 5 Public water supply 8 Air conditioning 11 Injection well
 1 Domestic 3 Feedlot 6 Oil field water supply 9 Dewatering 12 Other (Specify below)
 2 Irrigation 4 Industrial 7 Lawn and garden only **10** Monitoring well
 Was a chemical/bacteriological sample submitted to Department? Yes No **X**; If yes, mo/day/yr sample was submitted
 Water Well Disinfected? Yes No **X**

5] TYPE OF BLANK CASING USED:
 1 Steel 3 RMP (SR) 5 Wrought iron 8 Concrete tile CASING JOINTS: Glued Clamped
2 PVC 4 ABS 6 Asbestos-Cement 9 Other (specify below) Welded
 7 Fiberglass Threaded **X**
 Blank casing diameter **2** in. to **18** ft., Dia in. to ft., Dia in. to ft.
 Casing height above land surface **0** in., weight lbs./ft. Wall thickness or gauge No. **sch. 40**
 TYPE OF SCREEN OR PERFORATION MATERIAL:
 1 Steel 3 Stainless steel 5 Fiberglass **7** PVC 10 Asbestos-cement
 2 Brass 4 Galvanized steel 6 Concrete tile 8 RMP (SR) 11 Other (specify)
 12 None used (open hole)
 SCREEN OR PERFORATION OPENINGS ARE:
 1 Continuous slot **3** Mill slot 5 Gauzed wrapped 8 Saw cut 11 None (open hole)
 2 Louvered shutter 4 Key punched 6 Wire wrapped 9 Drilled holes
 7 Torch cut 10 Other (specify)
 SCREEN-PERFORATED INTERVALS: From **18** ft. to **33** ft., From ft. to ft.
 From ft. to ft., From ft. to ft.
 GRAVEL PACK INTERVALS: From **16** ft. to **33** ft., From ft. to ft.
 From ft. to ft., From ft. to ft.

6] GROUT MATERIAL: 1 Neat cement **2** Cement grout **3** Bentonite 4 Other
 Grout Intervals: From **0** ft. to **14** ft., From **14** ft. to **16** ft., From ft. to ft.
 What is the nearest source of possible contamination:
 1 Septic tank 4 Lateral lines 7 Pit privy **11** Fuel storage 14 Abandoned water well
 2 Sewer lines 5 Cess pool 8 Sewage lagoon 12 Fertilizer storage 15 Oil well/Gas well
 3 Watertight sewer lines 6 Seepage pit 9 Feedyard 13 Insecticide storage 16 Other (specify below)
 Direction from well? **southwest** How many feet? **125**

FROM	TO	LITHOLOGIC LOG	FROM	TO	PLUGGING INTERVALS
0	3"	cement			
3"	6'	cl. mod-drk brn, tr f-c snd, mod slty			
6	10	snd, v f-f grn, tr of grvl, lt-med gry			
10	15	snd, f-c, mod grvl, tr of rock, lt gry-yell-brn			
15	20	snd, v f-med grnd, yell-brn color			
20	28	snd, f-c grnd, mod grvl, tr of rock, yell-brn			
28	33	snd, f-c grnd, med-v rocky up to 2" in size, v grvly			
					PMW4flush mount cover

7] CONTRACTOR'S OR LANDOWNER'S CERTIFICATION: This water well was **1** constructed, (2) reconstructed, or (3) plugged under my jurisdiction and was completed on (mo/day/year) **11-09-93** and this record is true to the best of my knowledge and belief. Kansas Water Well Contractor's License No. **527** This Water Well Record was completed on (mo/day/yr) **12-15-93** under the business name of **GeoCore Services, Inc.** by (signature) *Bob A. [unclear]*