


705 Jones Ave, Garden City, Ks

Application Number:

**2841.68**

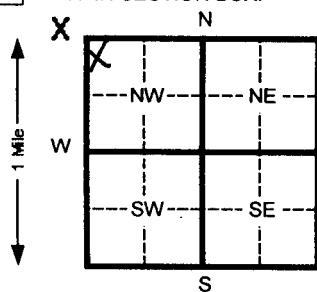

submitted Water Well Disinfected? Yes No **X**

## Contaminated Site

How many feet?

[illegible]

by (signature) 

Form provided by Forms-On-A-Disk, Inc. • Dallas, Texas • (214) 340-9429