

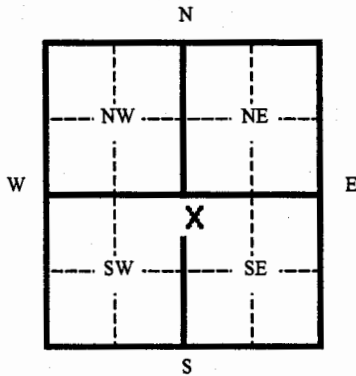
1 LOCATION OF WATER WELL:	Fraction	Section Number	Township Number	Range Number
County: Finney	NW 1/4 NW 1/4 SE 1/4	18	24	32 W

Distance and direction from nearest town or city street address of well if located within city?

In small parking lot at NW corner of intersection at Laurel & 7th Streets, Garden City, KS

2 WATER WELL OWNER:	Kansas Department of Health & Environment
RR#, St. Address, Box #	1000 SW Jackson Ste 410
City, State, ZIP Code	Topeka, KS 66612
	Board of Agriculture, Division of Water Resources
	Application Number:

3 MARK WELL'S LOCATION WITH AN "X" IN SECTION BOX:

4 DEPTH OF WELL **42.3** ft.WELL'S STATIC WATER LEVEL **31.32** ft.

WELL WAS USED AS:

- | | | |
|--------------|------------------------------|---------------------------|
| 1 Domestic | 5 Public Water Supply | 9 Dewatering |
| 2 Irrigation | 6 Oil Field Water Supply | 10 Monitoring Well |
| 3 Feedlot | 7 Lawn and Garden (domestic) | 11 Injection Well |
| 4 Industrial | 8 Air Conditioning | 12 Other |

Was a chemical/bacteriological sample submitted to Department? Yes No **X**

If yes, mo/day/yr sample was submitted

Water Well Disinfected: Yes No **X**

5 TYPE OF BLANK CASING USED:

- | | | | | |
|--------------|------------|-------------------|-----------------|-------------------------|
| 1 Steel | 3 RMP (SR) | 5 Wrought | 7 Fiberglass | 9 Other (specify below) |
| 2 PVC | 4 ABC | 6 Asbestos-Cement | 8 Concrete Tile | |

Blank casing diameter **2** in. Was casing pulled? Yes No **X** If yes, how muchCasing height above or below land surface **36** in. **Overdrilled 0 to 3 feet below the ground surface**6 GROUT PLUG MATERIAL: 1 Neat cement 2 Cement grout 3 Bentonite **4 Other Bentonite Grout**Grout Plug Intervals From **3** ft. to ft. From ft. to ft. From ft. to ft.

What is the nearest source of possible contamination:

- | | | | |
|--------------------------|-------------------|-------------------------|--------------------------|
| 1 Septic tank | 6 Seepage pit | 11 Fuel storage | 16 Other (specify below) |
| 2 Sewer lines | 7 Pit privy | 12 Fertilizer storage | |
| 3 Watertight sewer lines | 8 Sewage lagoon | 13 Insecticide storage | |
| 4 Lateral lines | 9 Feedyard | 14 Abandoned water well | |
| 5 Cess Pool | 10 Livestock pens | 15 Oil well/ Gas well | |

Direction from well? _____

How many feet? _____

FROM	TO	CODE	PLUGGING MATERIALS
0	3		Soil
3	42.3		Bentonite Grout slurry using tremie pipe/8 gal.

7	CONTRACTOR'S OR LANDOWNER'S CERTIFICATION: This water well was plugged under my jurisdiction and was completed on (mo/day/yr) 4-25-05 and this record is true to the best of my knowledge and belief. Kansas Water Well Contractor's License No. 531 This Water Well Record was completed on (mo/day/yr) 5-25-05 under the business name of Geotechnical Services, Inc. by (signature) <i>[Signature]</i>
---	---

INSTRUCTIONS: Please fill in blanks and circle the correct answers. Send three copies to Kansas Department of Health and Environment, Bureau of Water, 1000 S W Jackson St., Ste. 420, Topeka, Kansas 66620-0001. Telephone: 785-296-3565. Send one to Water Well Owner and retain one for your records.