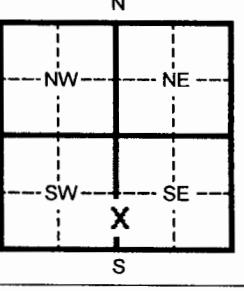
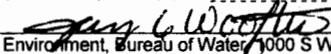


1 LOCATION OF WATER WELL: County: <b>Finney</b>		Fraction <b>NW 1/4 SE 1/4 SE 1/4</b>			Section Number <b>17</b>	Township Number <b>T 24 S</b>	Range Number <b>R 32 E</b>	
Distance and direction from nearest town or city street address of well if located within city?								
2 WATER WELL OWNER: <b>City of Garden City</b> RR#, St. Address, Box #: <b>125 JC St</b> City, State, ZIP Code: <b>Garden City, Ks 67846</b>				Board of Agriculture, Division of Water Resources Application Number:				
3 LOCATE WELL'S LOCATON WITH AN "X" IN SECTION BOX:								
		4 DEPTH OF COMPLETED WELL Depth(s) Groundwater Encountered <b>1</b> ft. 2 ft. 3 ft. WELL'S STATIC WATER LEVEL <b>38.95</b> ft. below land surface measured on mo/day/yr Pump test data: Well water was ft. after hours pumping gpm Est. Yield gpm: Well water was ft. after hours pumping gpm Bore Hole Diameter <b>8</b> in. to <b>55</b> ft. and in. to ft. WELL WATER TO BE USED AS: 5 Public water supply 8 Air conditioning 11 Injection well 1 Domestic 3 Feed lot 6 Oil field water supply 9 Dewatering 12 Other (Specify below) 2 Irrigation 4 Industrial 7 Lawn and garden (domestic) 10 Monitoring well			55 ft. ELEVATION:			
		Was a chemical/bacteriological sample submitted to Department? Yes <input checked="" type="checkbox"/> No <input type="checkbox"/> If yes, mo/day/yr sample was submitted Water Well Disinfected? Yes <input type="checkbox"/> No <input checked="" type="checkbox"/>						
5 TYPE OF BLANK CASING USED:		5 Wrought Iron 8 Concrete tile 6 Asbestos-Cement 9 Other (specify below) 7 Fiberglass			CASING JOINTS: Glued <input type="checkbox"/> Clamped <input type="checkbox"/> Welded <input type="checkbox"/> Threaded <input checked="" type="checkbox"/>			
1 Steel 3 RMP (SR) 2 PVC 4 ABS								
Blank casing diameter <b>2</b> in. to <b>30</b> ft., Dia		in. to <b>.716</b> ft. Dia			in. to ft., Dia			
Casing height above land surface <b>0</b> in., weight					lbs./ft. Wall thickness or gauge No. <b>.154</b>			
TYPE OF SCREEN OR PERFORATION MATERIAL:								
1 Steel 3 Stainless steel 2 Brass 4 Galvanized steel		5 Fiberglass 6 Concrete tile 7 Gauzed wrapped 8 Wire wrapped 9 Torch cut			7 PVC 10 Asbestos-cement 8 RMP (SR) 11 Other (specify) 9 ABS 12 None used (open hole)			
SCREEN OR PERFORATION OPENINGS ARE:		5 Gauzed wrapped 6 Wire wrapped 7 Torch cut			8 Saw cut 11 None (open hole) 9 Drilled holes 10 Other (specify)			
1 Continuous slot 3 Mill slot 2 Louvered shutter 4 Key punched								
SCREEN-PERFORATED INTERVALS: From <b>30</b> ft. to <b>55</b> ft. From								
GRAVEL PACK INTERVALS: From <b>28</b> ft. to <b>55</b> ft. From								
6 GROUT MATERIAL: 1 Neat cement 2 Cement grout		3 Bentonite		4 Other				
Grout Intervals From <b>2</b> ft. to <b>28</b> ft. From		ft. to		ft. From ft. to ft. From ft. to ft.				
What is the nearest source of possible contamination:								
1 Septic tank 4 Lateral lines 2 Sewer lines 5 Cess pool 3 Watertight sewer lines 6 Seepage pit		7 Pit privy 8 Sewage lagoon 9 Feedyard			10 Livestock pens 11 Fuel storage 12 Fertilizer storage 13 Insecticide storage 14 Abandoned water well 15 Oil well/ Gas well 16 Other (specify below) <b>Contaminated site</b>			
Direction from well?								
FROM	TO	CODE	LITHOLOGIC LOG		FROM	TO	PLUGGING INTERVALS	
<b>0</b>	<b>.5</b>		<b>Cement</b>					
<b>.5</b>	<b>2</b>		<b>Sandy clay</b>					
<b>2</b>	<b>33</b>		<b>Fine grained sand, w/scattered</b>					
			<b>Gravel, loose</b>					
<b>33</b>	<b>53</b>		<b>Mixed sand, gravel, pebbles, &amp; cobbles</b>					
<b>53</b>	<b>55</b>		<b>Pink sandy clay to clayey sand,</b>					
			<b>Very fine grained</b>					
7 CONTRACTOR'S OR LANDOWNER'S CERTIFICATION: This water well was (1) constructed, (2) reconstructed, or (3) plugged under my jurisdiction and was completed on (mo/day/yr) <b>11-30-05</b> and this record is true to the best of my knowledge and belief. Kansas								
Water Well Contractor's License No. <b>554</b> This Water Well Record was completed on (mo/day/yr) <b>12-16-05</b>								
under the business name of <b>Woofter Pump &amp; Well Inc.</b> by (signature) 								
INSTRUCTIONS: Please fill in blanks and circle the correct answers. Send three copies to Kansas Department of Health and Environment, Bureau of Water, 1000 S W Jackson St, Ste. 420, Topeka, Kansas 66612-1367. Telephone: 913-296-5545. Send one to WATER WELL OWNER and retain one for your records.								