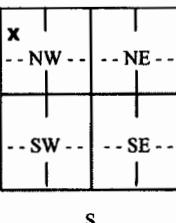
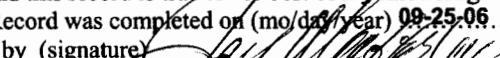


WATER WELL RECORD

Form WWC-5

Division of Water Resources; App. No. _____

1 LOCATION OF WATER WELL: County: Finney		Fraction NW ¼ NW ¼ NW ¼	Section Number 18	Township Number T 24 S	Range Number R 32 E/W																		
Distance and direction from nearest town or city street address of well if located within city? 601 W Kansas Ave - Garden City, KS		Global Positioning Systems (decimal degrees, min. of 4 digits) Latitude: 37°58'28.6" Longitude: 100°52'50.1"																					
2 WATER WELL OWNER: Burtis Motor Co., Inc. RR#, St. Address, Box #: 601 W Kansas Ave. City, State, ZIP Code: Garden City, KS 67846		Elevation: _____ Datum: _____ Data Collection Method: _____																					
3 LOCATE WELL'S LOCATION WITH AN "X" IN SECTION BOX: 		4 DEPTH OF COMPLETED WELL .49..... ft.																					
		Depth(s) Groundwater Encountered (1)..... ft. (2)..... ft. (3)..... ft. WELL'S STATIC WATER LEVEL 34.37 ft. below land surface measured on mo/day/yr. 08-15-06 Pump test data: Well water was..... ft. after..... hours pumping..... gpm Est. Yield..... gpm: Well water was..... ft. after..... hours pumping..... gpm WELL WATER TO BE USED AS: 5 Public water supply 8 Air conditioning 11 Injection well 1 Domestic 3 Feedlot 6 Oil field water supply 9 Dewatering 12 Other (Specify below) 2 Irrigation 4 Industrial 7 Domestic (lawn & garden) 10 Monitoring well MW-7R																					
		Was a chemical/bacteriological sample submitted to Department? Yes No ✓ ; If yes, mo/day/ys Sample was submitted..... Water well disinfected? Yes No ✓																					
5 TYPE OF CASING USED: <table border="0"><tr><td>1 Steel</td><td>3 RMP (SR)</td><td>5 Wrought Iron</td><td>8 Concrete tile</td><td>CASING JOINTS: Glued..... Clamped.....</td></tr><tr><td>2 PVC</td><td>4 ABS</td><td>6 Asbestos-Cement</td><td>9 Other (specify below)</td><td>Welded.....</td></tr><tr><td colspan="4">7 Fiberglass</td><td>Threaded..... ✓</td></tr></table>		1 Steel	3 RMP (SR)	5 Wrought Iron	8 Concrete tile	CASING JOINTS: Glued..... Clamped.....	2 PVC	4 ABS	6 Asbestos-Cement	9 Other (specify below)	Welded.....	7 Fiberglass				Threaded..... ✓							
1 Steel	3 RMP (SR)	5 Wrought Iron	8 Concrete tile	CASING JOINTS: Glued..... Clamped.....																			
2 PVC	4 ABS	6 Asbestos-Cement	9 Other (specify below)	Welded.....																			
7 Fiberglass				Threaded..... ✓																			
Blank casing diameter 4 in. to ft., Diameter in. to ft., Diameter in. to ft. Casing height above land surface. .25 in., Weight 2.00 lbs./ft. Wall thickness or guage No. Sch 40																							
TYPE OF SCREEN OR PERFORATION MATERIAL: <table border="0"><tr><td>1 Steel</td><td>3 Stainless Steel</td><td>5 Fiberglass</td><td>7 PVC</td><td>9 ABS</td><td>11 Other (Specify)</td></tr><tr><td>2 Brass</td><td>4 Galvanized Steel</td><td>6 Concrete tile</td><td>8 RM (SR)</td><td>10 Asbestos-Cement</td><td>12 None used (open hole)</td></tr></table>		1 Steel	3 Stainless Steel	5 Fiberglass	7 PVC	9 ABS	11 Other (Specify)	2 Brass	4 Galvanized Steel	6 Concrete tile	8 RM (SR)	10 Asbestos-Cement	12 None used (open hole)										
1 Steel	3 Stainless Steel	5 Fiberglass	7 PVC	9 ABS	11 Other (Specify)																		
2 Brass	4 Galvanized Steel	6 Concrete tile	8 RM (SR)	10 Asbestos-Cement	12 None used (open hole)																		
SCREEN OR PERFORATION OPENINGS ARE: <table border="0"><tr><td>1 Continuous slot</td><td>3 Mill slot</td><td>0.040</td><td>5 Guazed wrapped</td><td>7 Torch cut</td><td>9 Drilled holes</td><td>11 None (open hole)</td></tr><tr><td>2 Louvered shutter</td><td>4 Key punched</td><td></td><td>6 Wire wrapped</td><td>8 Saw Cut</td><td>10 Other (specify)</td><td></td></tr></table>		1 Continuous slot	3 Mill slot	0.040	5 Guazed wrapped	7 Torch cut	9 Drilled holes	11 None (open hole)	2 Louvered shutter	4 Key punched		6 Wire wrapped	8 Saw Cut	10 Other (specify)									
1 Continuous slot	3 Mill slot	0.040	5 Guazed wrapped	7 Torch cut	9 Drilled holes	11 None (open hole)																	
2 Louvered shutter	4 Key punched		6 Wire wrapped	8 Saw Cut	10 Other (specify)																		
SCREEN-PERFORATED INTERVALS: From .29 ft. to .49 ft., From ft. to ft. From ft. to ft., From ft. to ft. GRAVEL PACK INTERVALS: From .26.9 ft. to .49 ft., From ft. to ft. From ft. to ft., From ft. to ft.																							
6 GROUT MATERIAL: 1 Neat cement 2 Cement grout 3 Bentonite 4 Other																							
Grout Intervals: From .26.9 ft. to .0.6 ft., From .0.6 ft. to 0.concrete . ft., From ft. to ft.																							
What is the nearest source of possible contamination: <table border="0"><tr><td>1 Septic tank</td><td>4 Lateral lines</td><td>7 Pit privy</td><td>10 Livestock pens</td><td>13 Insecticide Storage</td><td>16 Other (specify)</td></tr><tr><td>2 Sewer lines</td><td>5 Cess pool</td><td>8 Sewage lagoon</td><td>11 Fuel storage</td><td>14 Abandoned water well</td><td>below)</td></tr><tr><td>3 Watertight sewer lines</td><td>6 Seepage pit</td><td>9 Feedyard</td><td>12 Fertilizer Storage</td><td>15 Oil well/gas well</td><td>.....</td></tr></table>		1 Septic tank	4 Lateral lines	7 Pit privy	10 Livestock pens	13 Insecticide Storage	16 Other (specify)	2 Sewer lines	5 Cess pool	8 Sewage lagoon	11 Fuel storage	14 Abandoned water well	below)	3 Watertight sewer lines	6 Seepage pit	9 Feedyard	12 Fertilizer Storage	15 Oil well/gas well				
1 Septic tank	4 Lateral lines	7 Pit privy	10 Livestock pens	13 Insecticide Storage	16 Other (specify)																		
2 Sewer lines	5 Cess pool	8 Sewage lagoon	11 Fuel storage	14 Abandoned water well	below)																		
3 Watertight sewer lines	6 Seepage pit	9 Feedyard	12 Fertilizer Storage	15 Oil well/gas well																		
Direction from well? West How many feet? 40																							
FROM	TO	LITHOLOGIC LOG	FROM	TO	PLUGGING INTERVALS																		
0	0.5	Concrete																					
0.5	6.5	Silt																					
6.5	9	Sand																					
9	16	Silty Sand																					
16	18	Sand																					
18	20.5	Silt																					
20.5	49	Sand																					

7 CONTRACTOR'S OR LANDOWNER'S CERTIFICATION: This water well was (1) constructed, (2) reconstructed, or (3) plugged under my jurisdiction and was completed on (mo/day/year) **08-15-06**..... and this record is true to the best of my knowledge and belief. Kansas Water Well Contractor's License No. **554**..... This Water Well Record was completed on (mo/day/year) **09-25-06**..... under the business name of **Woofter Pump & Well, Inc.** by (signature) 

INSTRUCTIONS: Use typewriter or ball point pen. **PLEASE PRESS FIRMLY** and **PRINT** clearly. Please fill in blanks, underline or circle the correct answers. Send top three copies to Kansas Department of Health and Environment, Bureau of Water, Geology Section, 1000 SW Jackson St, Suite 420, Topeka, Kansas 66612-1367. Telephone 785-296-5522. Send one to WATER WELL OWNER and retain one for your records. Fee of \$5.00 for each constructed well. Visit us at <http://www.kdhe.state.ks.us/geo/waterwells>.